

Harry L. Greene, Surveyor


2160 Tremont Center, Columbus, Ohio 43221

To: Federated Mortgage Corporation

Re: Mark S. & Joan Stuhlreyer

Being Lot No. 4, BRITTANY LANE, a subdivision in the City of Upper Arlington, Ohio of record in Plat Book 63, Page 63, Recorder's Office, Franklin County, Ohio.
1205 Brittany Lane.

PB. 63 Page 63 Recorder's Office, Franklin County, Ohio.
Scale 1" = 20' Date July 22, 1986

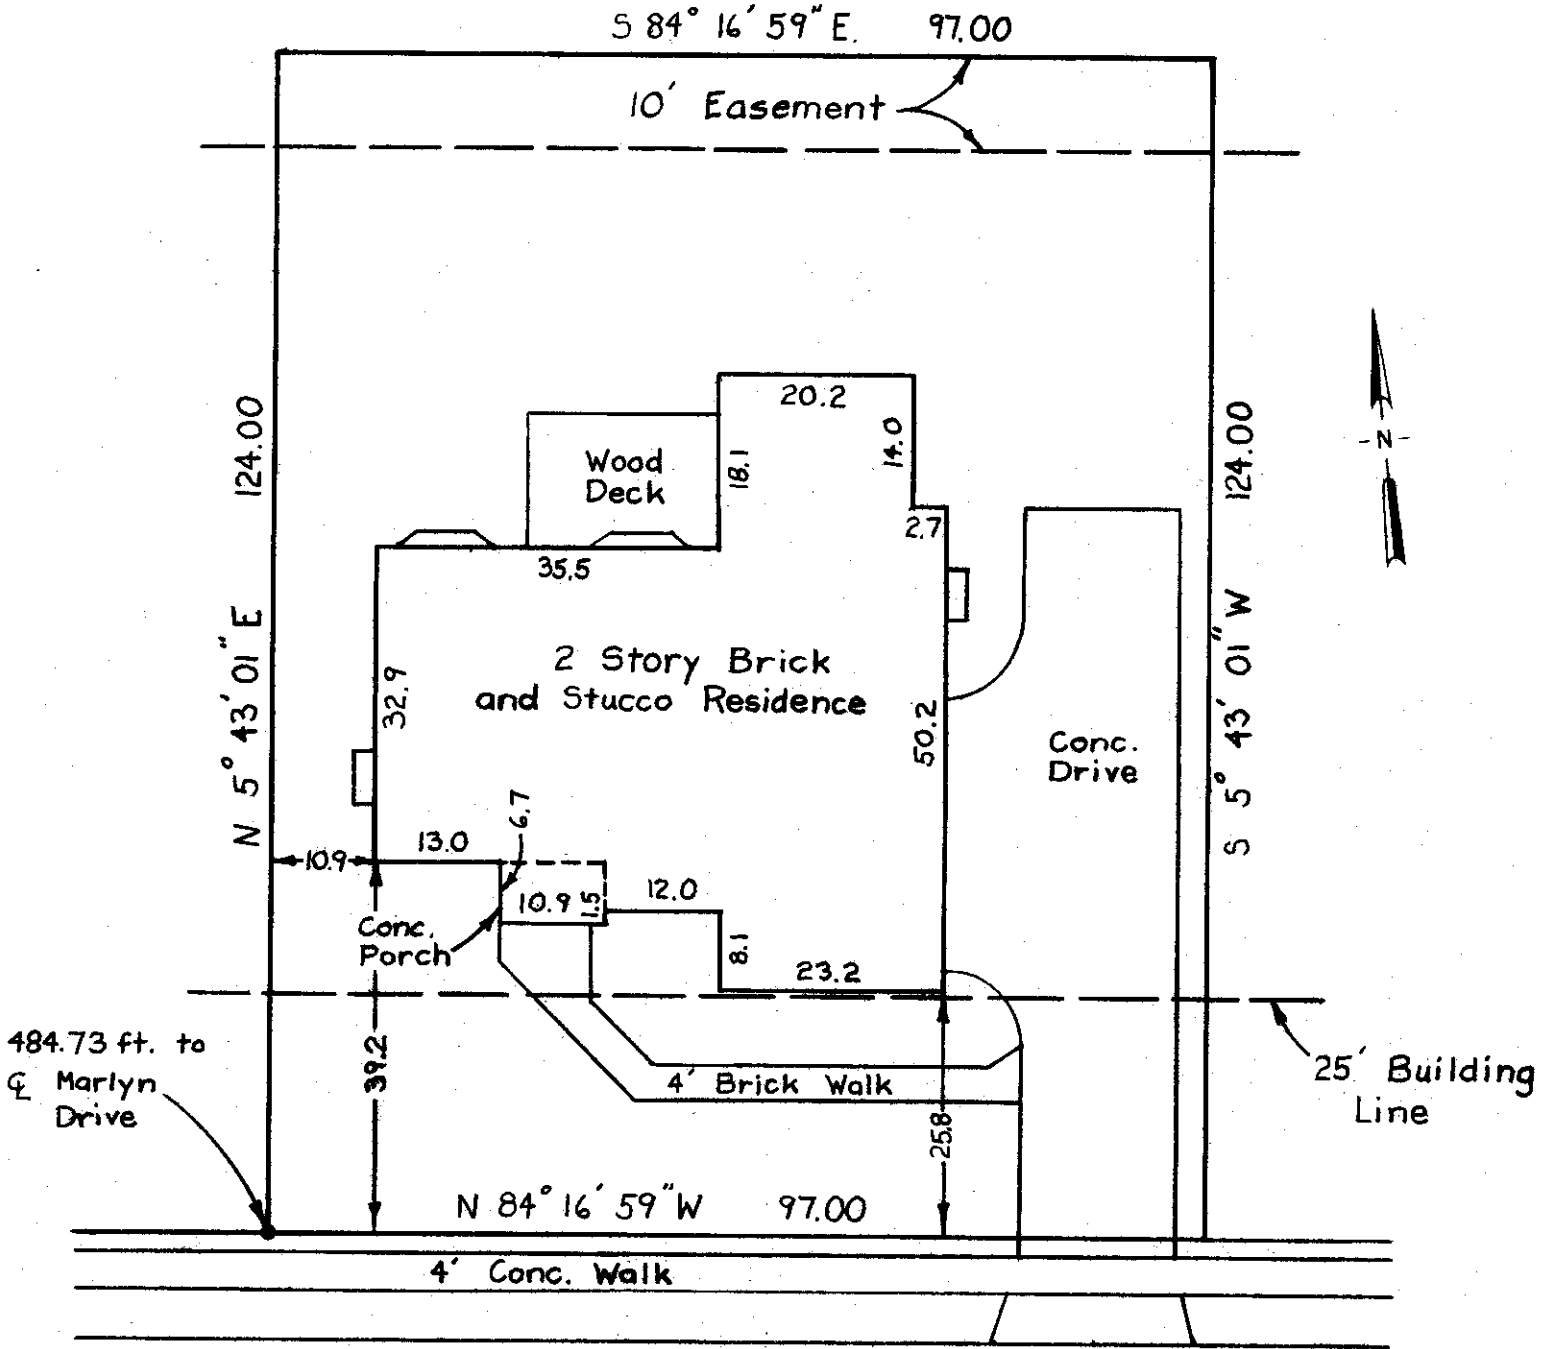

BRITTANY LANE (50')

I hereby certify the above plat has been prepared from actual survey of the premises for use in mortgage loan and title purposes only. No sideline of principal building is less than dimension shown. Property corners not located unless shown thus -o-.

Harry L. Greene
Harry L. Greene, Registered Surveyor, No. 4058