

Harry L. Greene, Surveyor


2160 Tremont Center, Columbus, Ohio 43221

Plat showing survey and location of residence at 2664 Chester Rd.
Being Lots #77, 78, College Hill Add. Upper Arlington, Ohio.
Re; Chris Painchaud.

PB. 10 Page 354-5 Recorders Office, Franklin County, Ohio.
Scale 1" = 20' Date June 16, 1986

Chester Rd. 50' R.O.W.

4' C.W.

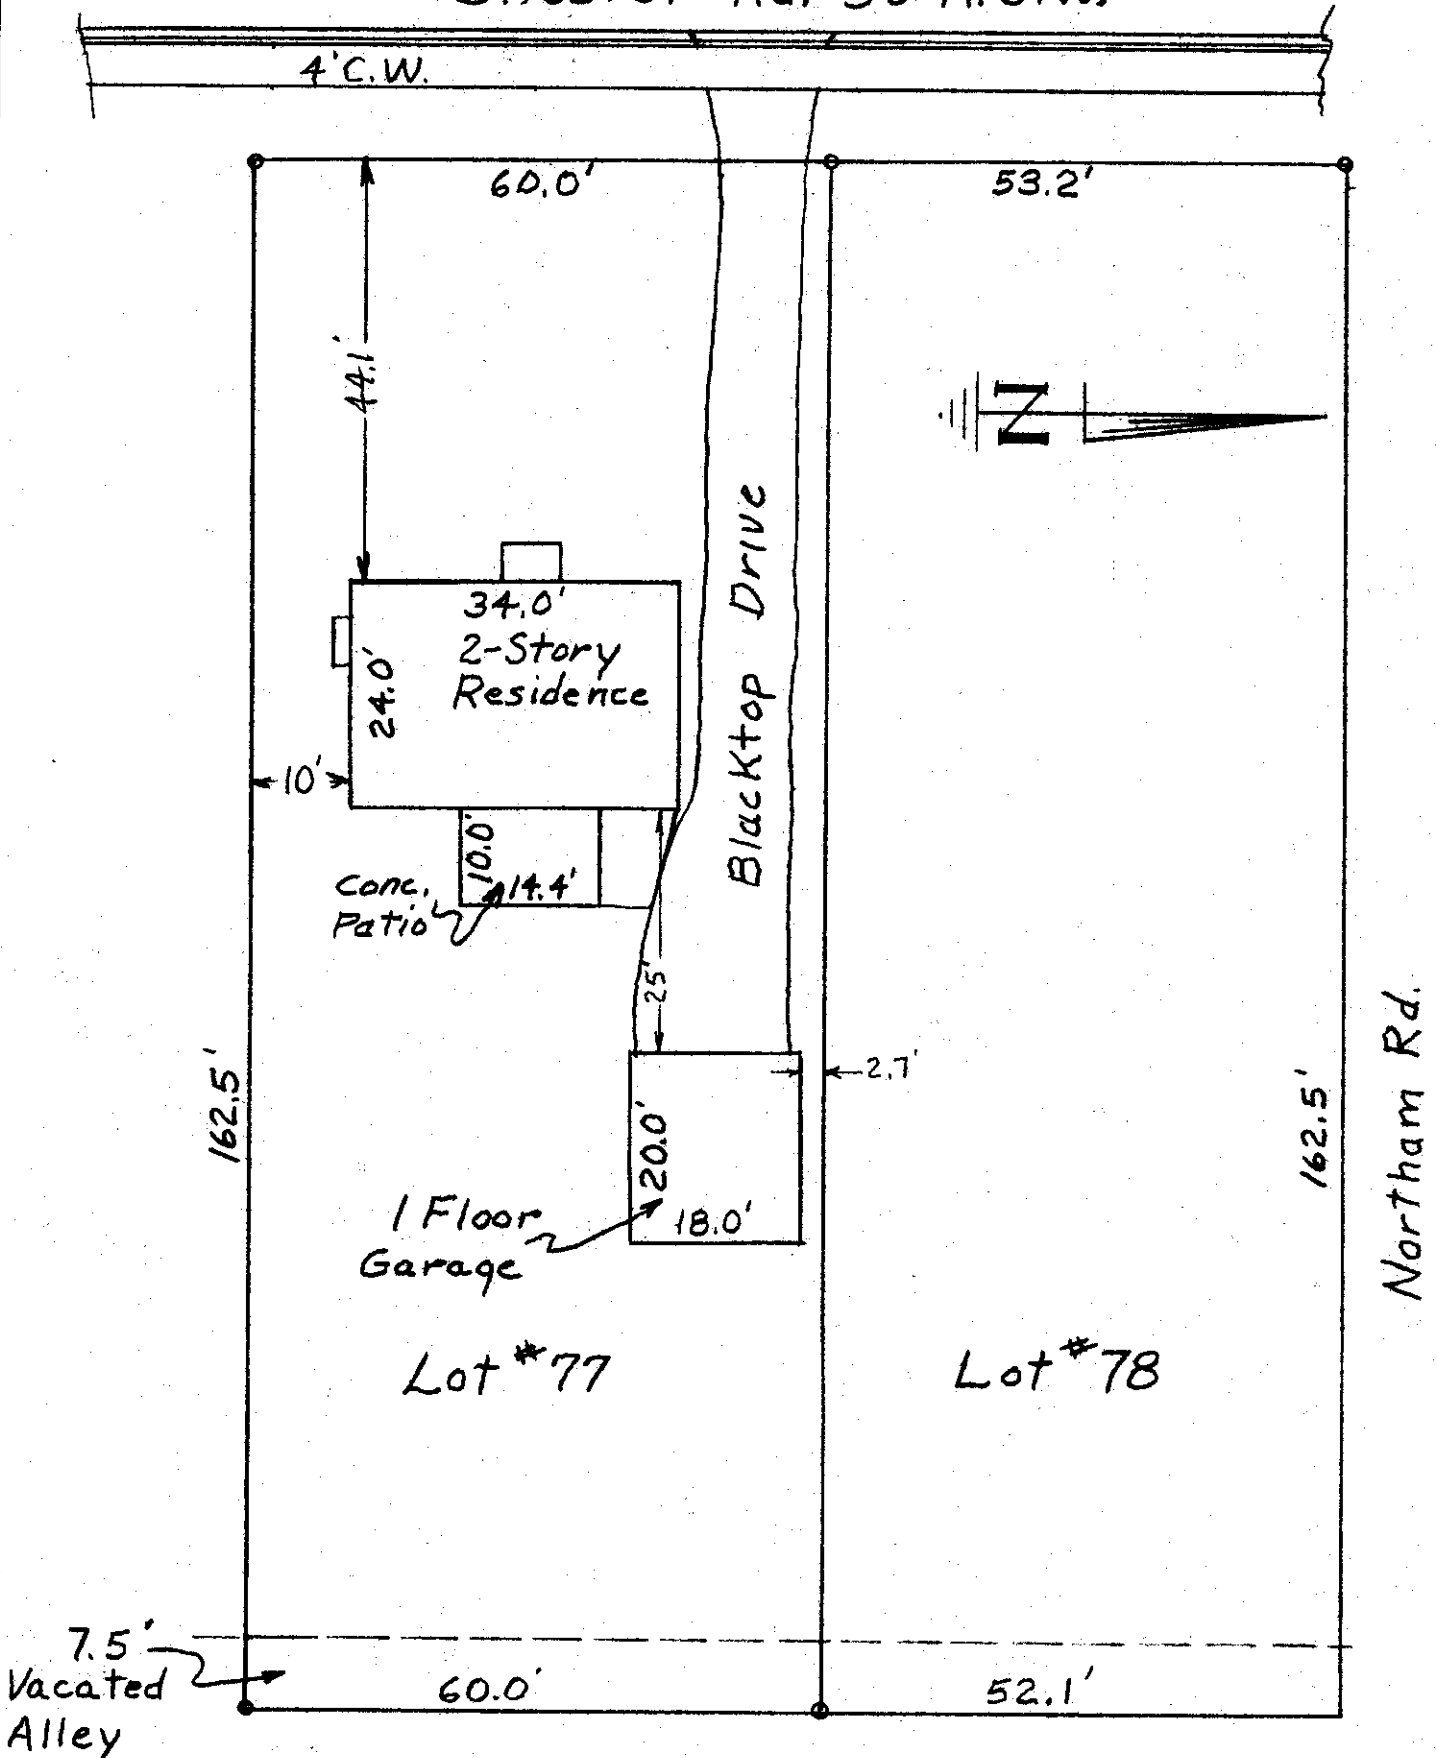

7.5' Vacated Alley

I hereby certify the above plat has been prepared from actual survey of the premises for use in mortgage loan and title purposes only. No sideline of principal building is less than dimension shown. Property corners not located unless shown thus -o-.

Harry L. Greene
Harry L. Greene, Registered Surveyor, No. 4058