


# Harry L. Greene, Surveyor

2160 Tremont Center, Columbus, Ohio 43221

Plat showing Survey of Lot No. 2, Block 13 of Upper Arlington, and a part of Lot No. 1 and part of Lot No. 13, Block 13 of Upper Arlington, Upper Arlington, Ohio 2000 Devon Road  
 To: Title First Agency Inc., & BancOhio National Bank

RE: Douglas R. Anderson & Susan D. Anderson

PB. 12 Page 23424 Recorders Office, Franklin County, Ohio.  
 Scale 1" = 20' Date July 1, 1985 Revised July 1, 1986

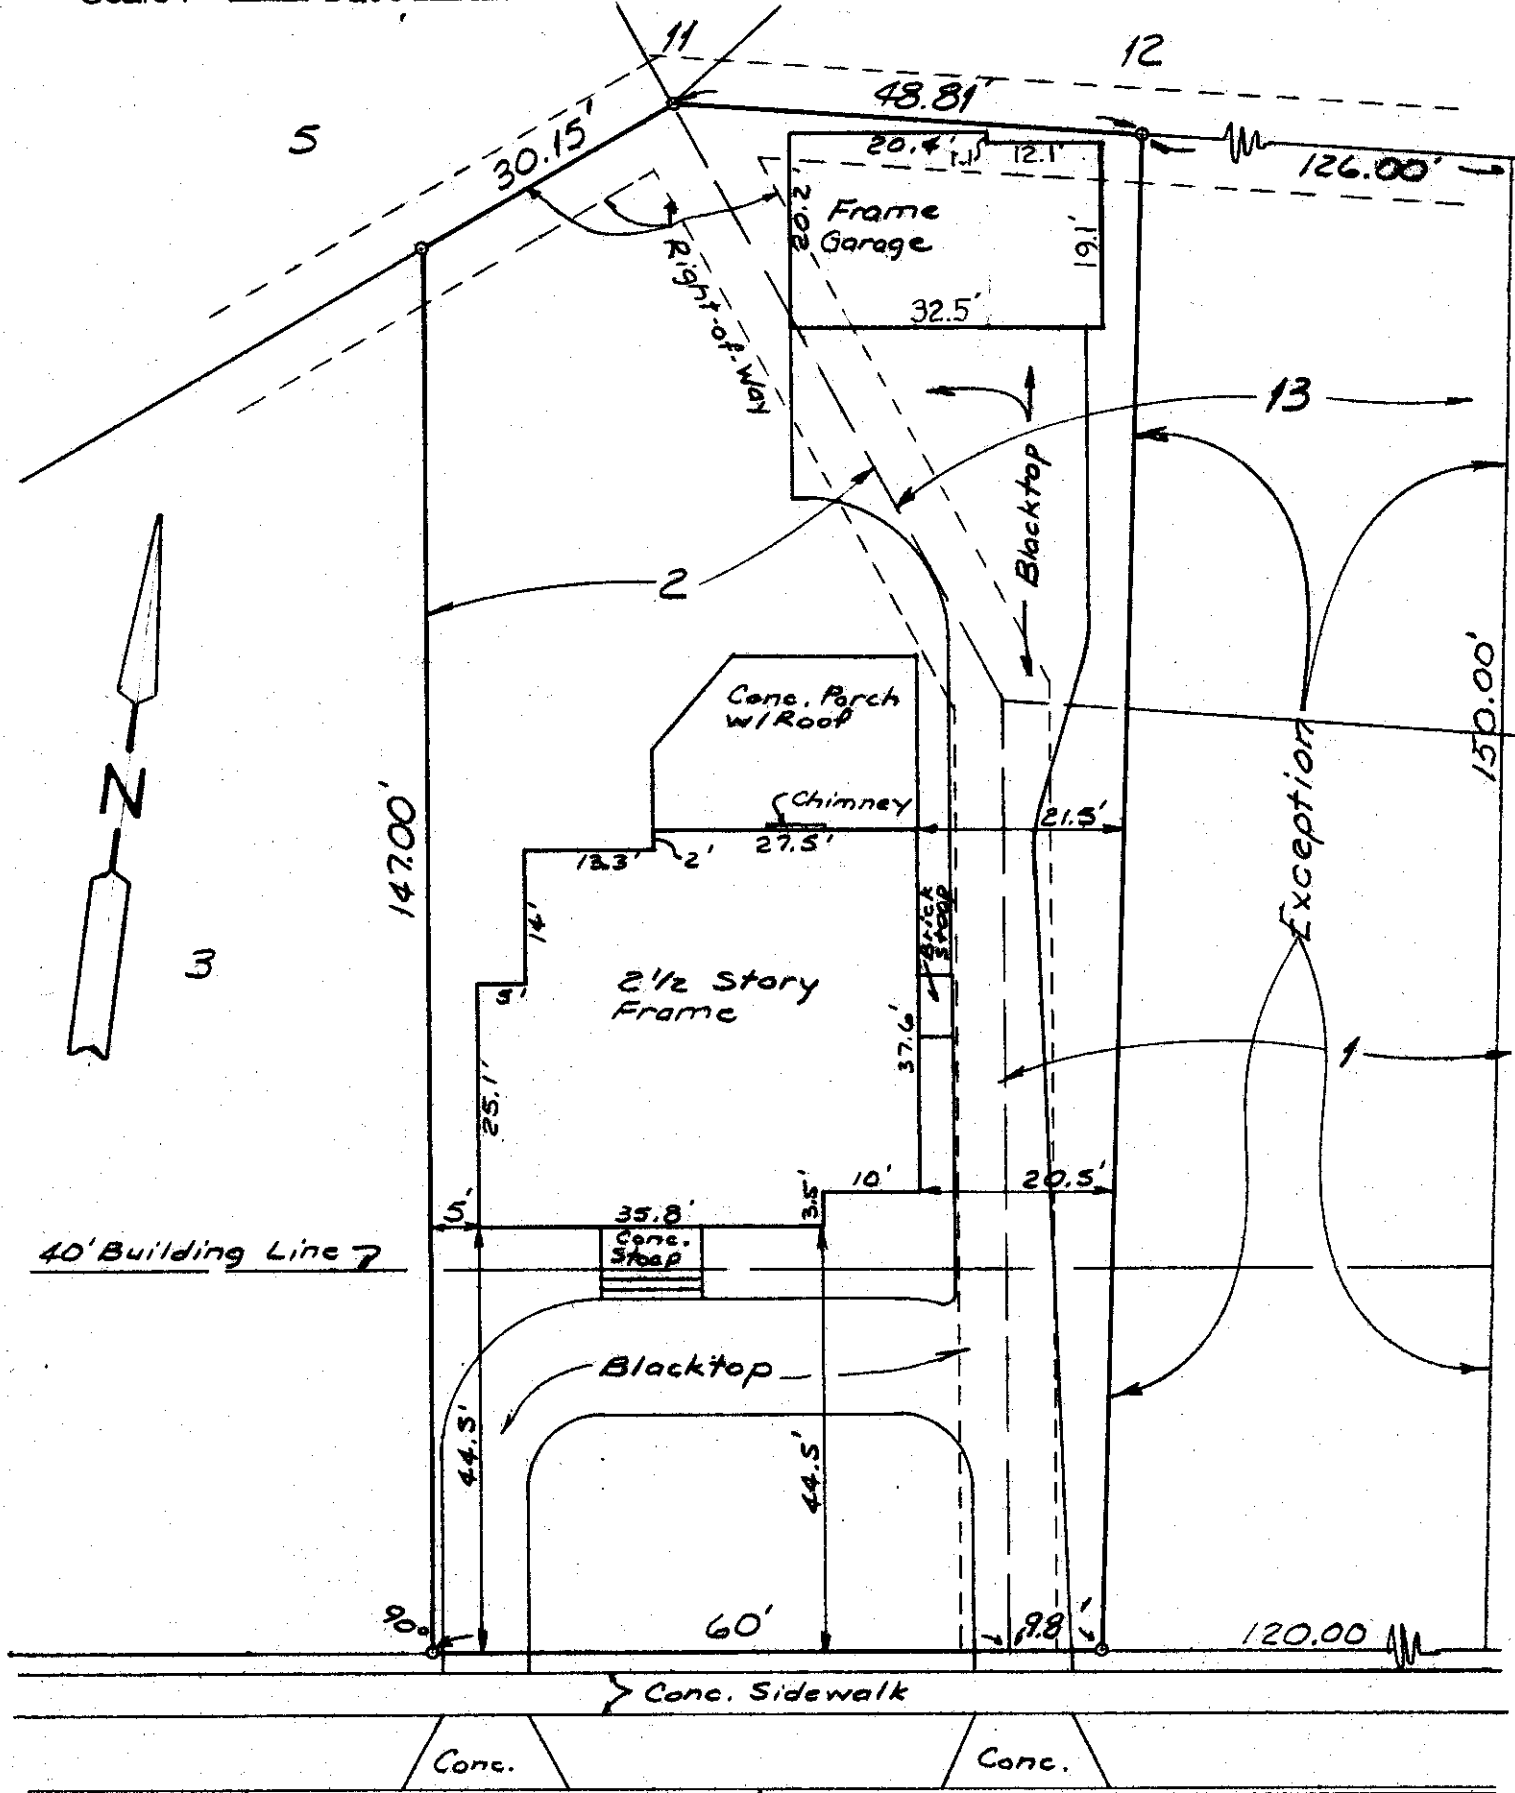

I hereby certify the above plat has been prepared from actual survey of the premises for use in mortgage loan and title purposes only. No sideline of principal building is less than dimension shown. Property corners not located unless shown thus -o-.

27' 8 1/2"  
 DEVON ROAD 50'  
*Harry L. Greene*  
 Harry L. Greene, Registered Surveyor, No. 4058