


# Harry L. Greene, Surveyor

2160 Tremont Center, Columbus, Ohio 43221

Plat showing Survey of Lot 8 and a part of Lot 9, SUNDRIDGE FAIRWAY ADDITION, City of Upper Arlington, Franklin County, Ohio.  
To: Commonwealth Title Agency, Inc.  
and/or Ameritrust Company National Association

Re: John R. Glenn.  
1685 Sundridge Drive

PB. 25 Page 26 Recorders Office, FRANKLIN County, Ohio.  
Scale 1" = 30' Date FEB. 17, 1986 Revised July 2, 1986

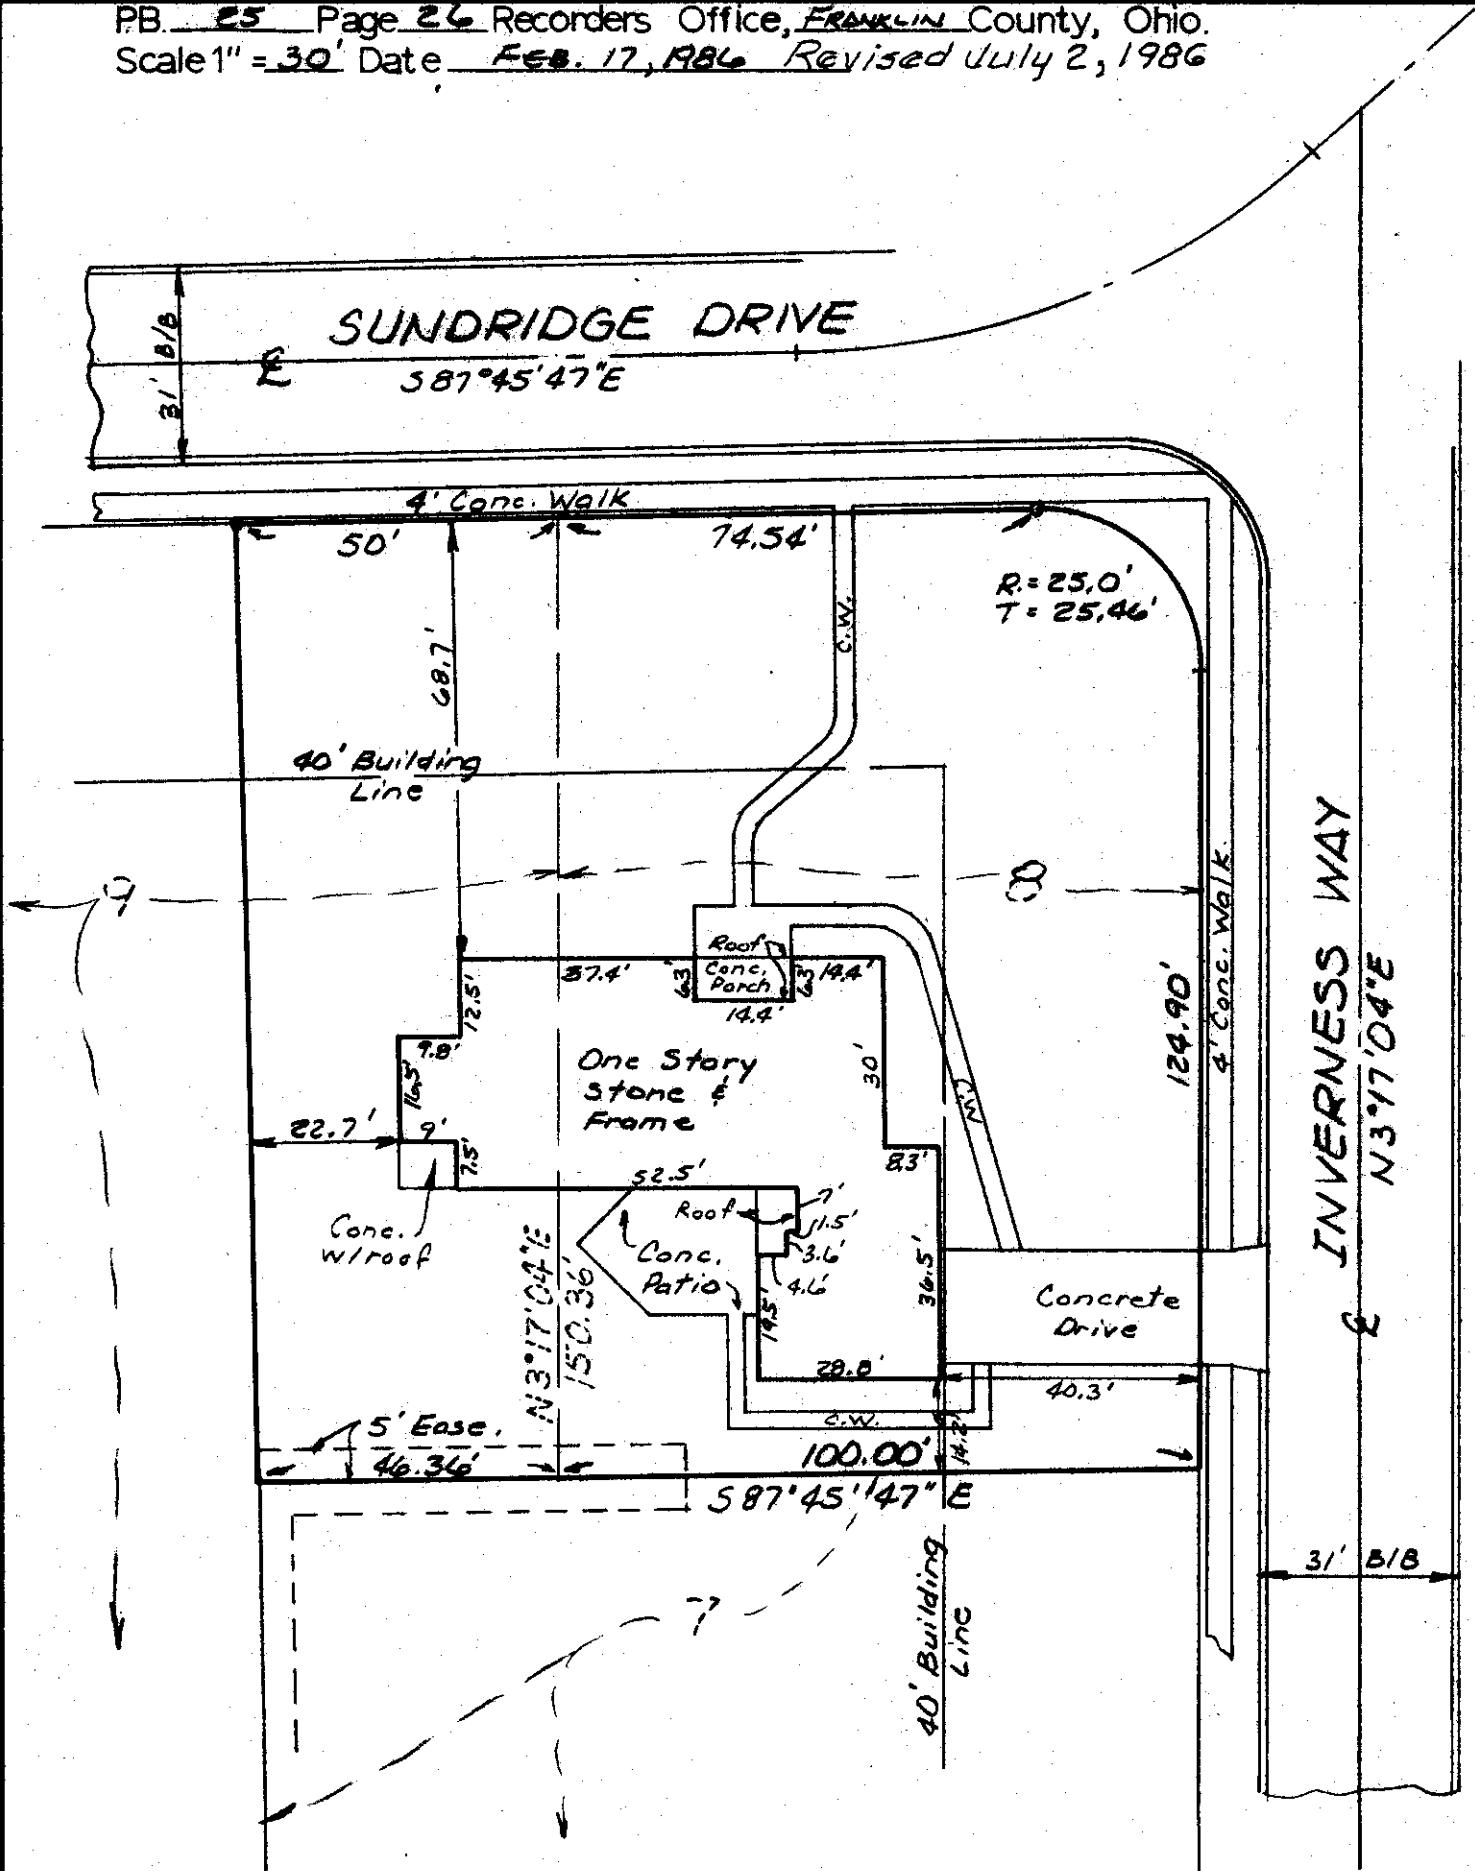

I hereby certify the above plat has been prepared from actual survey of the premises for use in mortgage loan and title purposes only. No sideline of principal building is less than dimension shown. Property corners not located unless shown thus -o-

*Jacob T. Hawk*  
JACOB T. HAWK, Registered Surveyor, No. 7035