


Harry L. Greene, Surveyor

2160 Tremont Center, Columbus, Ohio 43221


Plat showing survey of Lot No. 228, BEACON SECOND SUBDIVISION
City of Hilliard, Ohio

For: James A. Moore

PB. 31 Page 5 Recorders Office, Franklin County, Ohio.
Scale 1" = 20' Date July -1, 1986

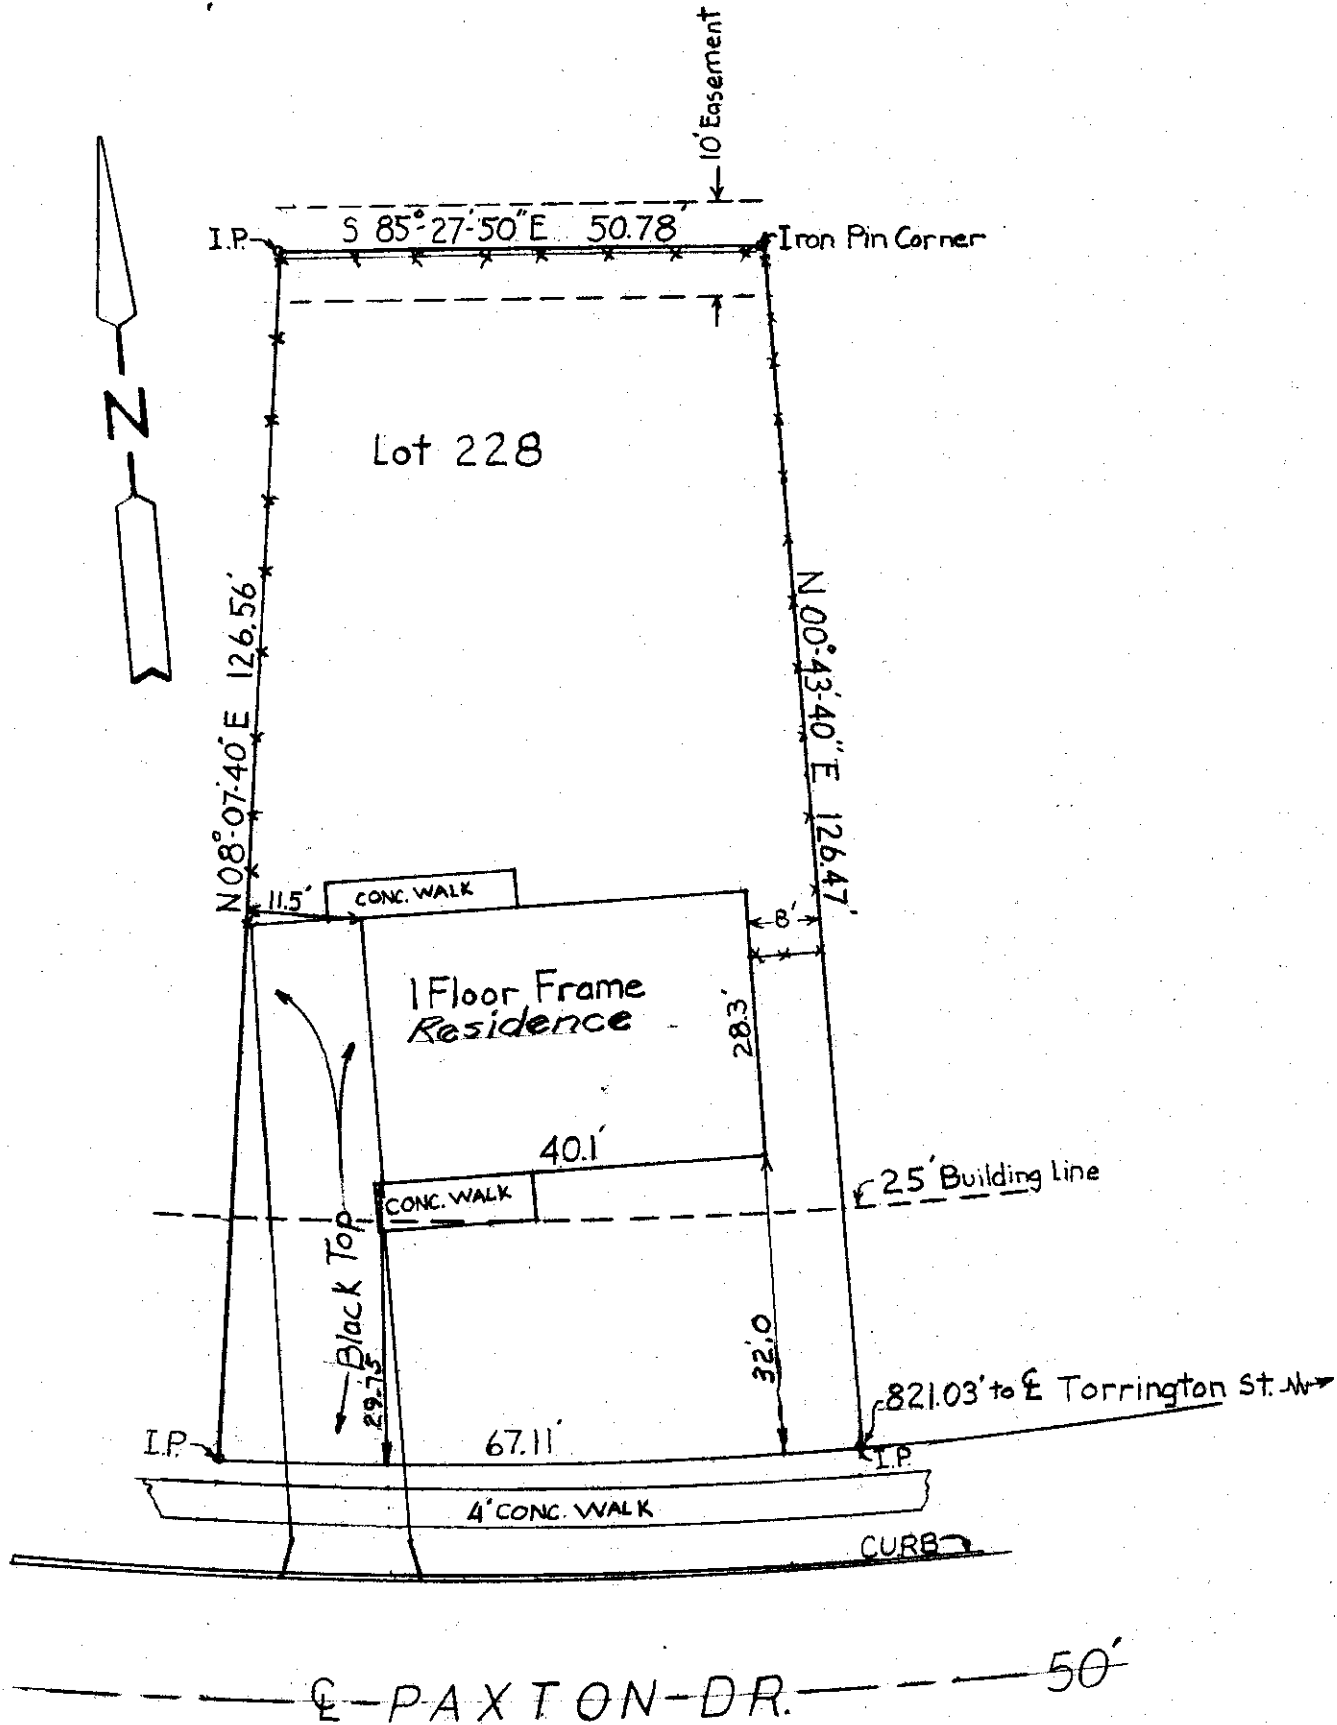

I hereby certify the above plat has been prepared from actual survey of the premises for use in mortgage loan and title purposes only. No sideline of principal building is less than dimension shown. Property corners not located unless shown thus -o-.

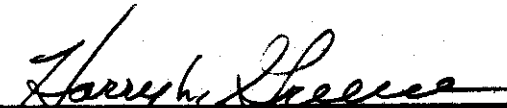
 Harry L. Greene, Registered Surveyor, No. 4058