

Harry L. Greene, Surveyor


2160 Tremont Center, Columbus, Ohio 43221

PLAT SHOWING SURVEY OF LOT NO. 83, VAN B. DELASHMUTT AMENDED PLAT, 1522 HESS STREET, CITY OF COLUMBUS, FRANKLIN COUNTY, OHIO.

For. Mr. Jeffrey S. Brown,

PB. _____ Page _____ Recorders Office, FRANKLIN County, Ohio.
Scale 1" = 20' Date DEC. 1, 1987

22' ALLEY

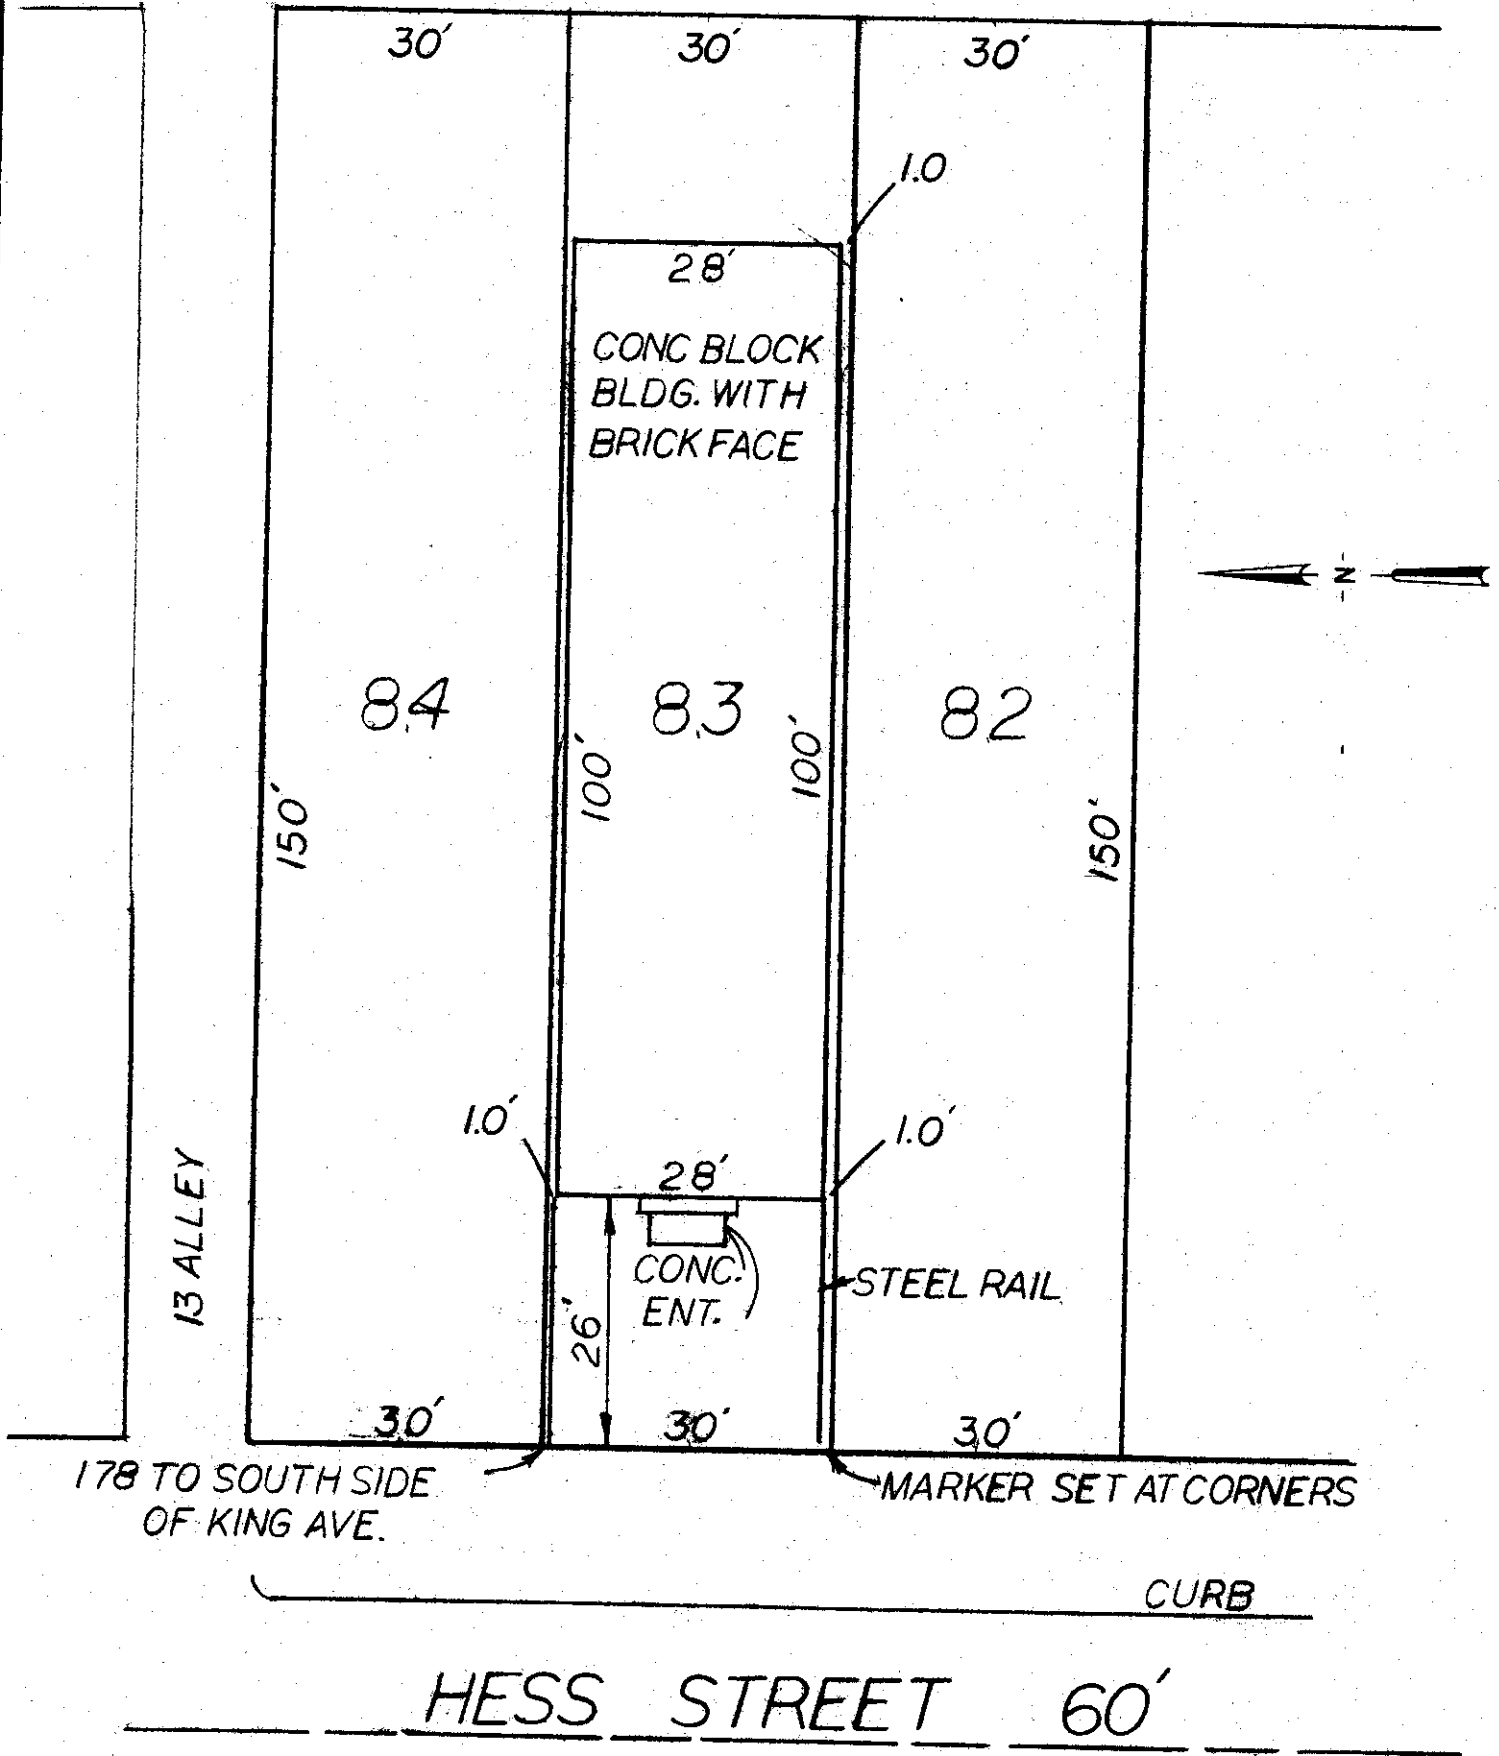

I hereby certify the above plat has been prepared from actual survey of the premises for use in mortgage loan and title purposes only. No sideline of principal building is less than dimension shown. Property corners not located unless shown thus -o-.

Harry L. Greene
Harry L. Greene, Registered Surveyor, No. 4058