


# Harry L. Greene, Surveyor

2160 Tremont Center, Columbus, Ohio 43221

To: Minnesota Title Insurance Company  
 Freedom Federal Savings and Loan.  
 Re: Richard C. and Moynan O'Brien

Being Lot No. 56, BEECHWOLD, City of Columbus, Ohio  
 (123 W. Jeffrey Place.)

PB. 12 Page 33 Recorders Office, Franklin County, Ohio.  
 Scale 1" = 20' Date Jan. 8, 1987  
 Revised Sept 10/87

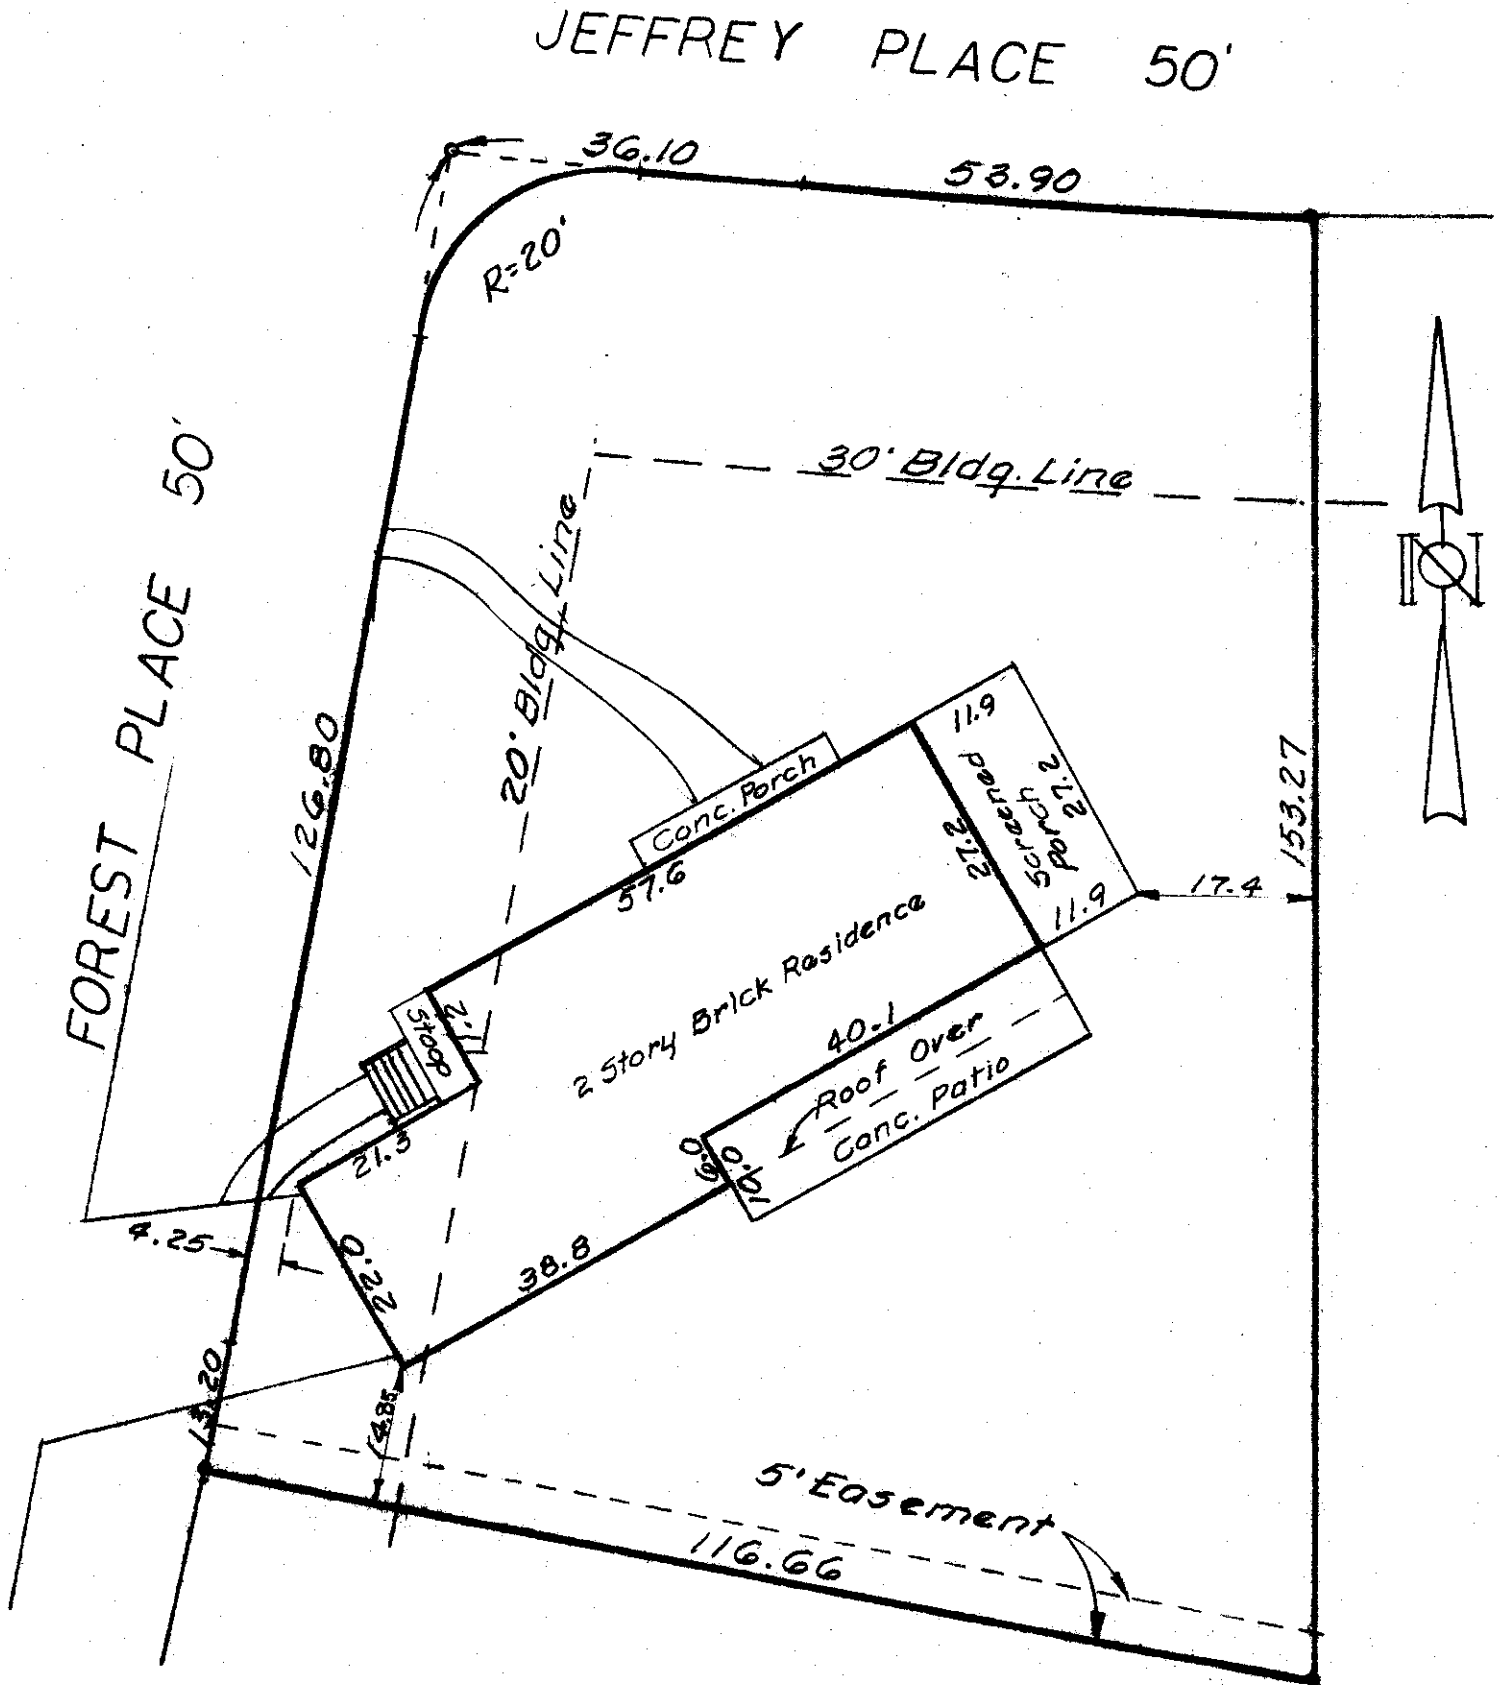

I hereby certify the above plat has been prepared from actual survey of the premises for use in mortgage loan and title purposes only. No sideline of principal building is less than dimension shown. Property corners not located unless shown thus -o-.

*Harry L. Greene*  
 Harry L. Greene, Registered Surveyor, No. 4058