
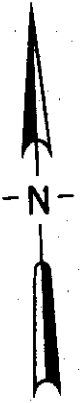


Harry L. Greene, Surveyor

2160 Tremont Center, Columbus, Ohio 43221

Plat showing Lot 18 of the VARGO SUBDIVISION, City of Upper
Arlington, Franklin County, Ohio.

PB. 24 Page 32 Recorders Office, Franklin County, Ohio.
Scale 1" = 30' Date JULY 24, 1987

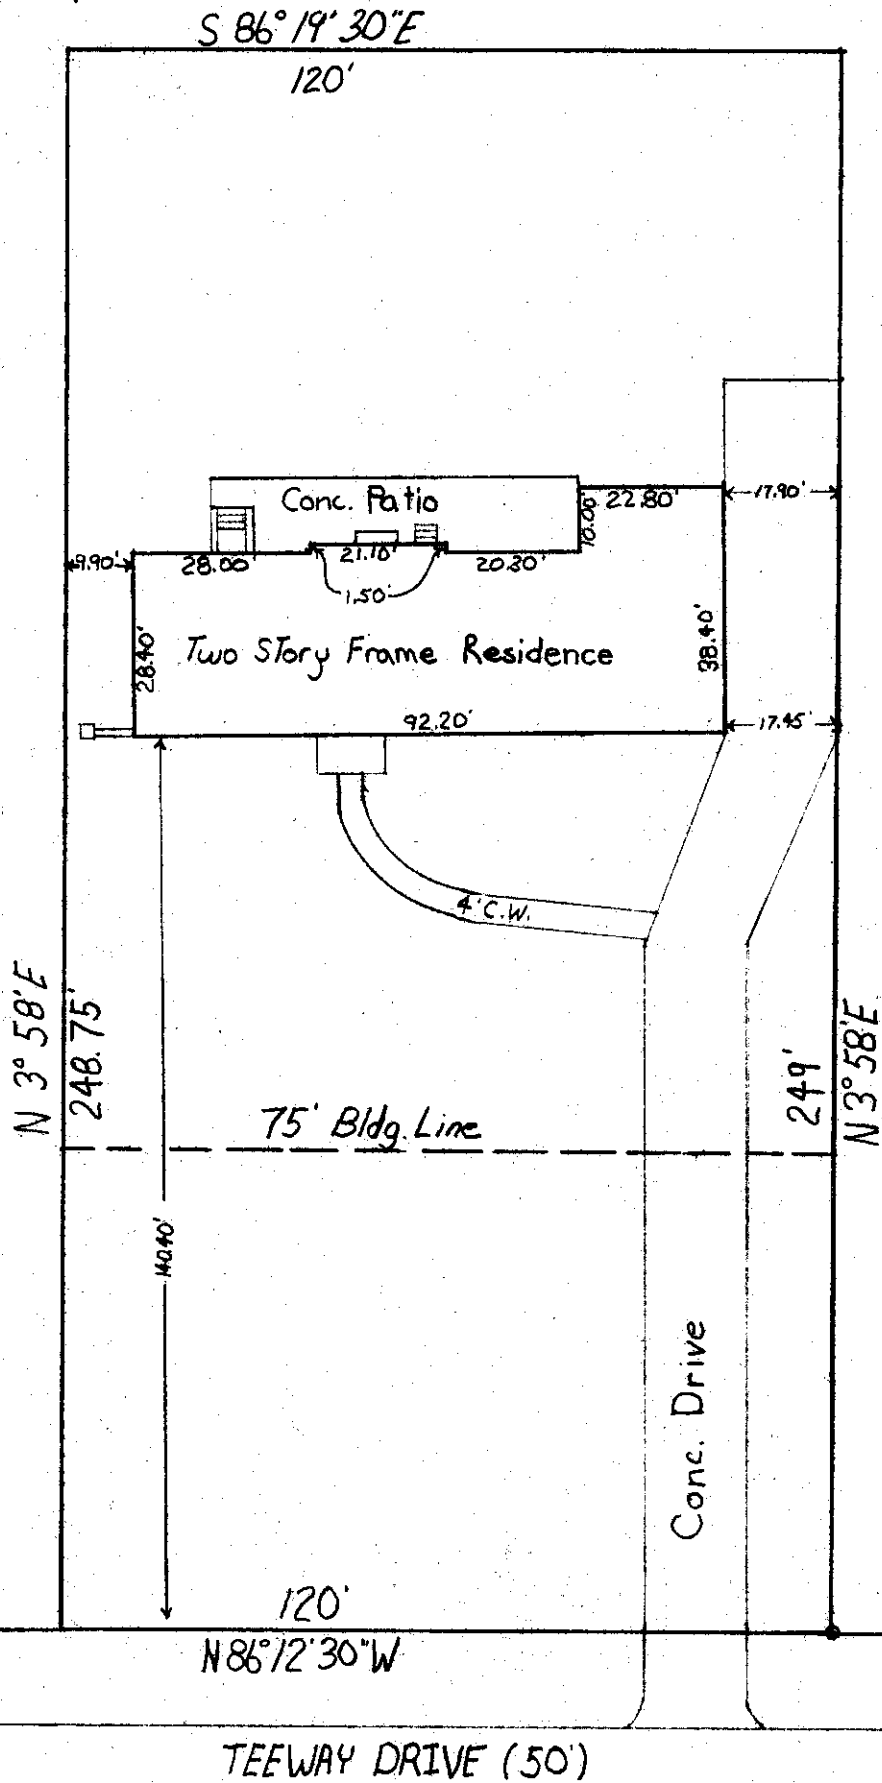

I hereby certify the above plat has been prepared from actual survey of the premises.

No sideline of principal building is less than dimension shown. Property corners not located unless shown thus -o-.

Harry L. Greene
Harry L. Greene, Registered Surveyor, No. 4058