


Harry L. Greene, Surveyor

2160 Tremont Center, Columbus, Ohio 43221

PLAT SHOWING SURVEY OF LOTS 6, 7 AND 8, OF RICKETTS, SMITH AND GOODS WHITE ROSE ADDITION, City of Columbus, Ohio.

PB. _____ Page _____ Records Office, Franklin County, Ohio.
Scale 1" = 20 Date July 7, 1987

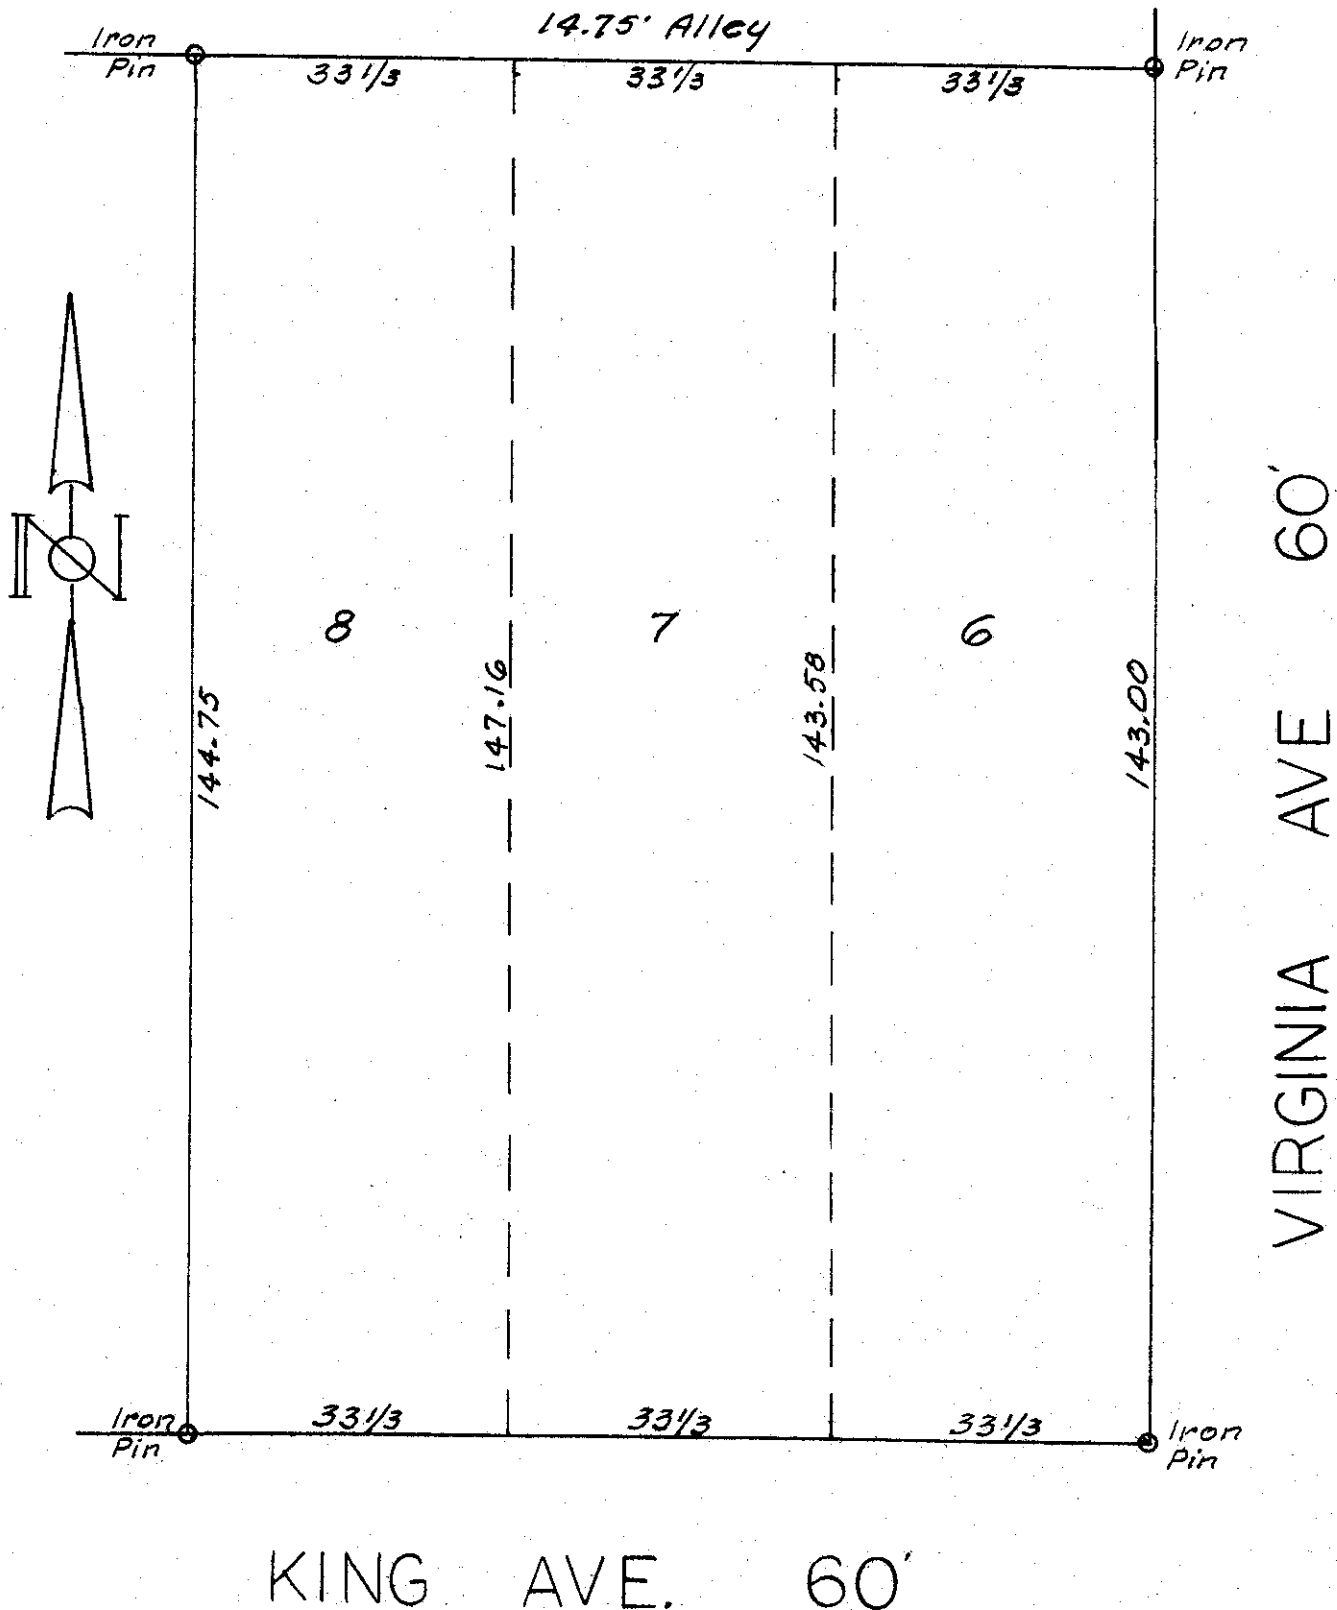

I hereby certify the above plat has been prepared from actual survey of the premises ~~shown on this plat~~ only. ~~Property corners not located unless shown thus -o-~~. Property corners not located unless shown thus -o-.

Harry L. Greene
Harry L. Greene, Registered Surveyor, No. 4058