


# Harry L. Greene, Surveyor

2160 Tremont Center, Columbus, Ohio 43221

Plat showing survey of Lot #10 Block #13 The University Addition.  
Re; Jeffrey W. Brantner 1644 Cardiff RD.

PB. 16 Page 39 Recorders Office, Franklin County, Ohio.  
Scale 1" = 20' Date June 5, 1987

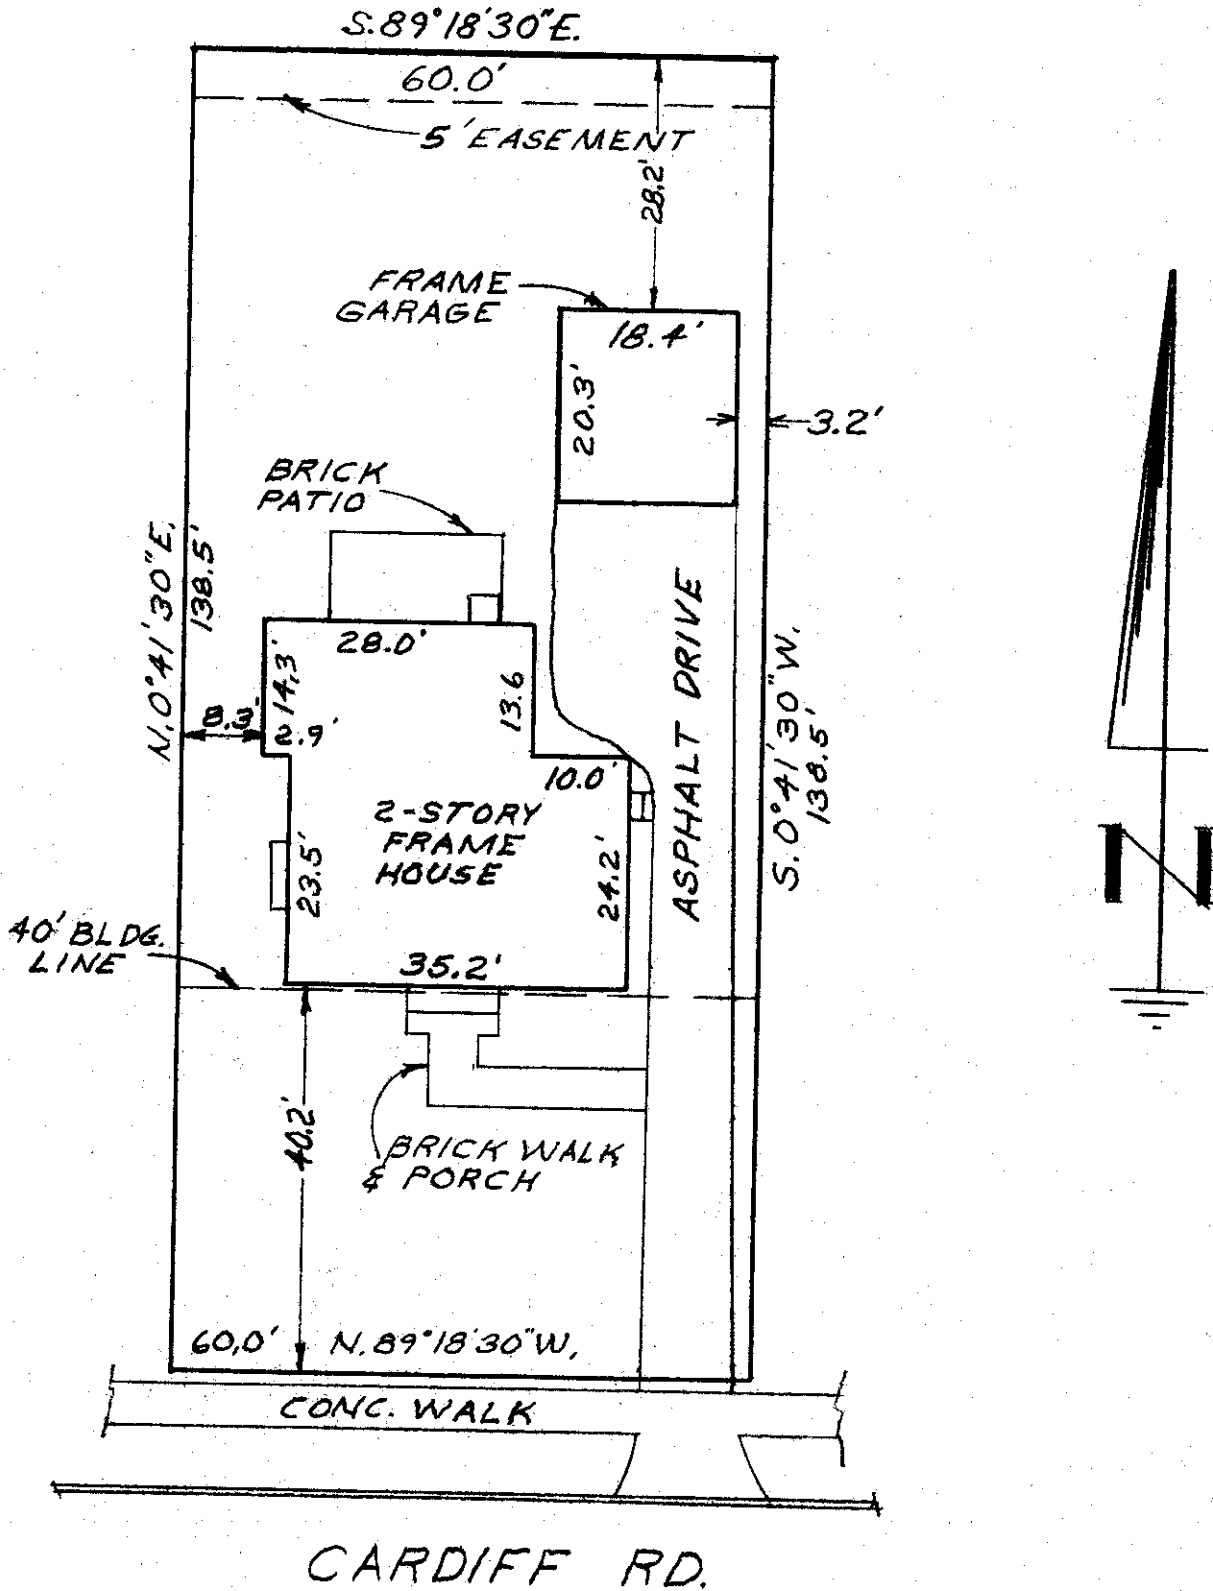

I hereby certify the above plat has been prepared from actual survey of the premises

No sideline of principal building is less than dimension shown. Property corners not located unless shown thus -o-

*Harry L. Greene*  
Harry L. Greene, Registered Surveyor, No. 4058