



# Harry L. Greene, Surveyor

2160 Tremont Center, Columbus, Ohio 43221

PLAT SHOWING SURVEY OF LOT NO. 13, REEDCREST ADDITION NO. 1, CITY OF UPPER ARLINGTON, FRANKLIN COUNTY, OHIO.

For: E. Cordero.  
4151 Mumford Road,

PB. 52 Page 5 Recorders Office, Franklin County, Ohio.  
Scale 1" = 20 Date May 14, 1987

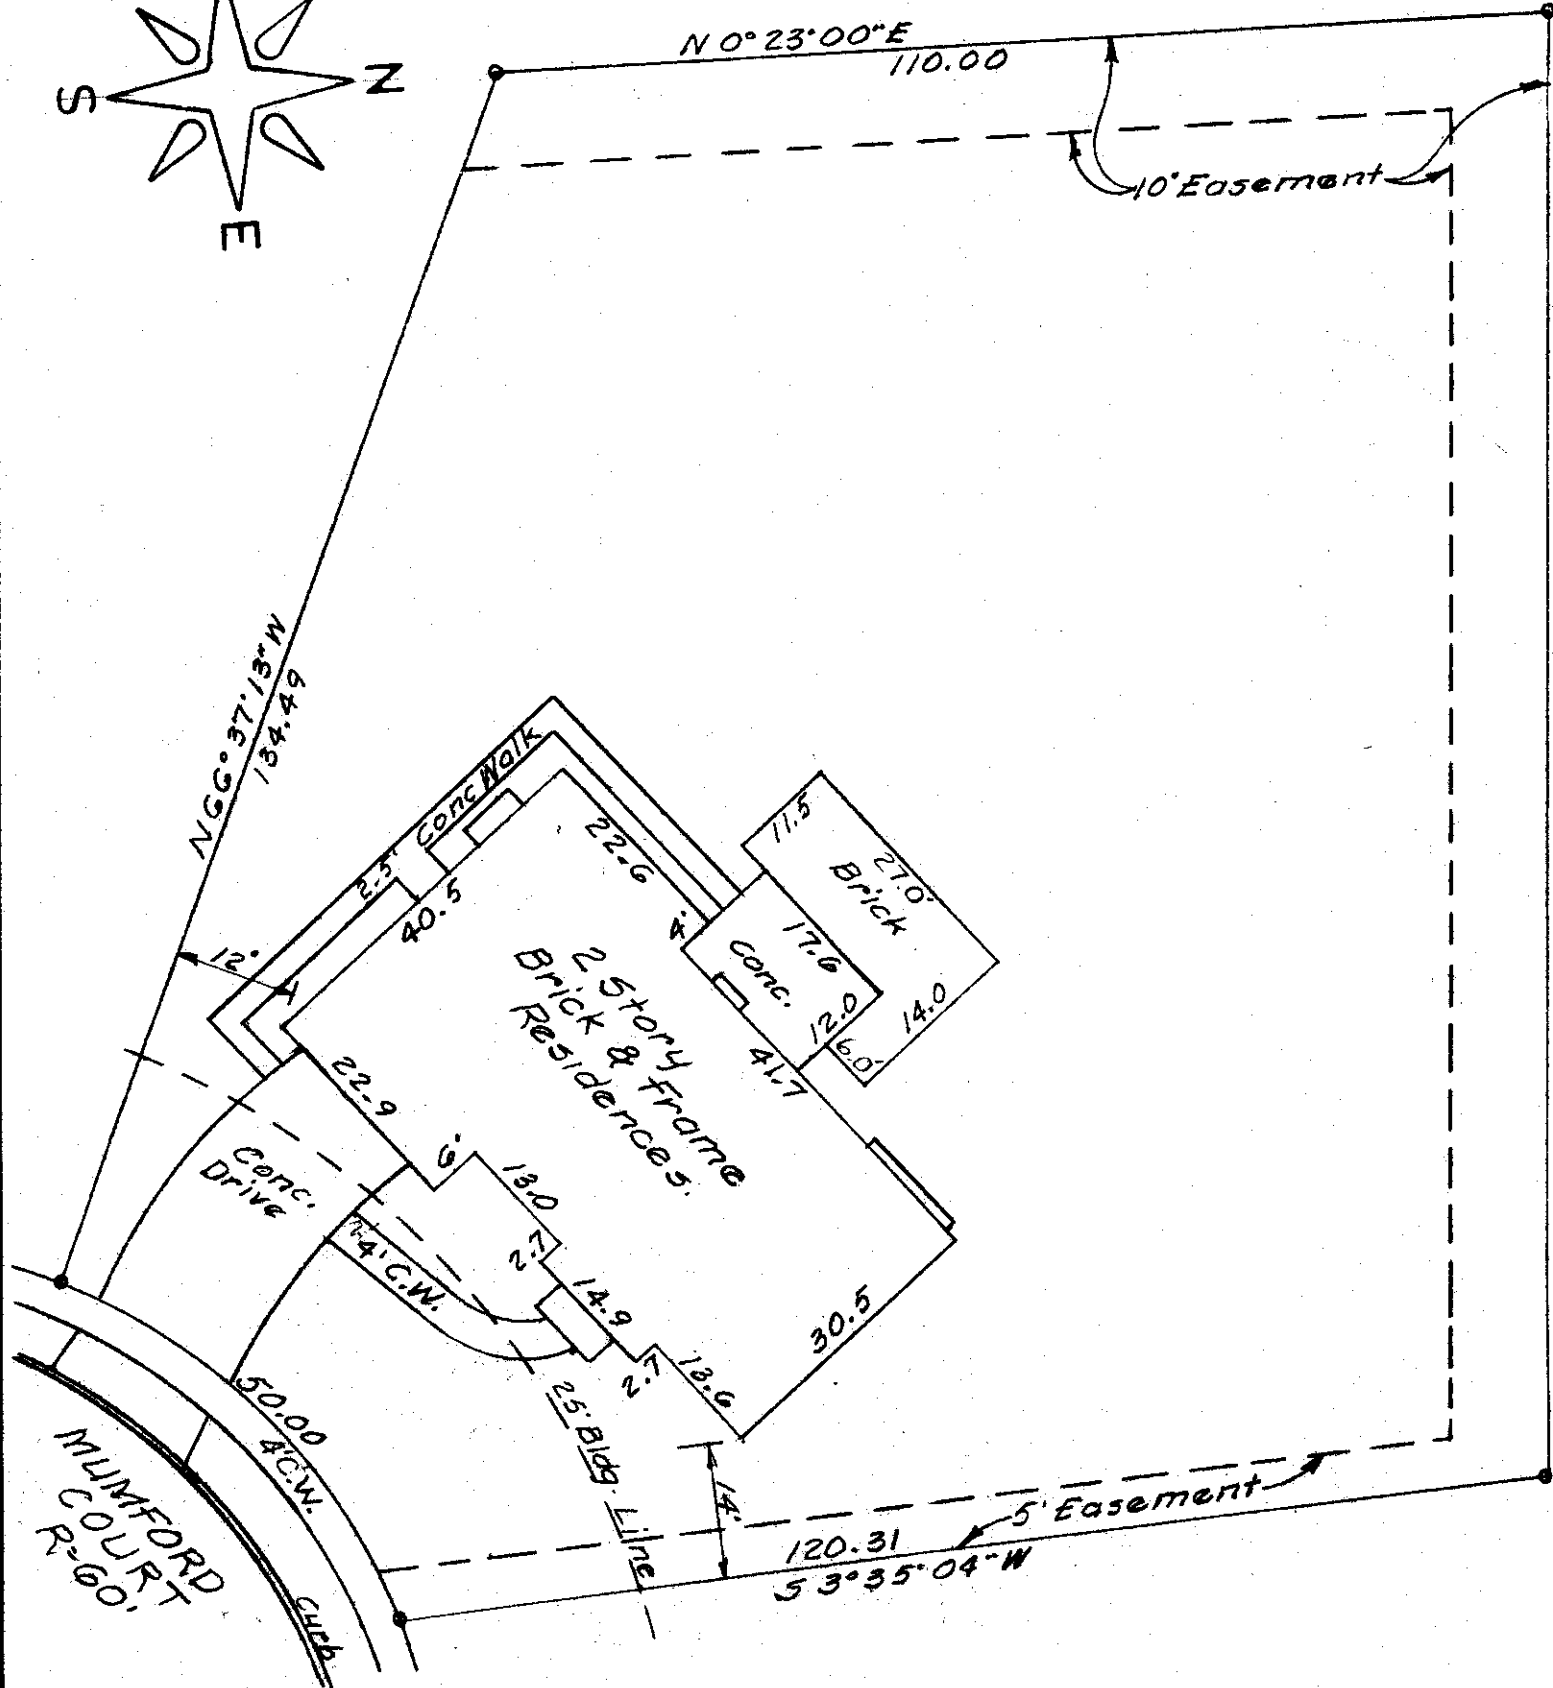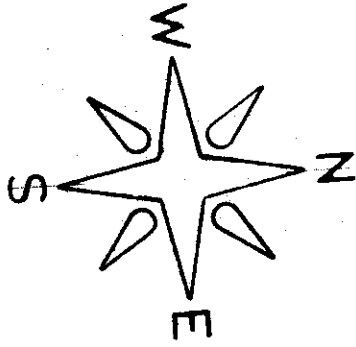

I hereby certify the above plat has been prepared from actual survey of the premises ~~and no other means were used in the preparation of this plat.~~ No sideline of principal building is less than dimension shown. Property corners not located unless shown thus -o-.

*Harry L. Greene*  
Harry L. Greene, Registered Surveyor, No. 4058