

Harry L. Greene, Surveyor


2160 Tremont Center, Columbus, Ohio 43221

To: Minnesota Title Insurance Co.
 Re: Michael Greene & Mary Ellen Forrester,

Being Lot No. 113, AMENDMENT OF A PART OF EASTMOOR ADDITION,
 Plat Book 18, Page 49, Recorder's Office, Franklin County, Ohio
 233 Eastmoor Boulevard, City of Columbus, Ohio

PB. 18 Page 49 Recorder's Office, FRANKLIN County, Ohio.
 Scale 1" = 20' Date APRIL 28, 1987

EASTMOOR BLVD. (75')

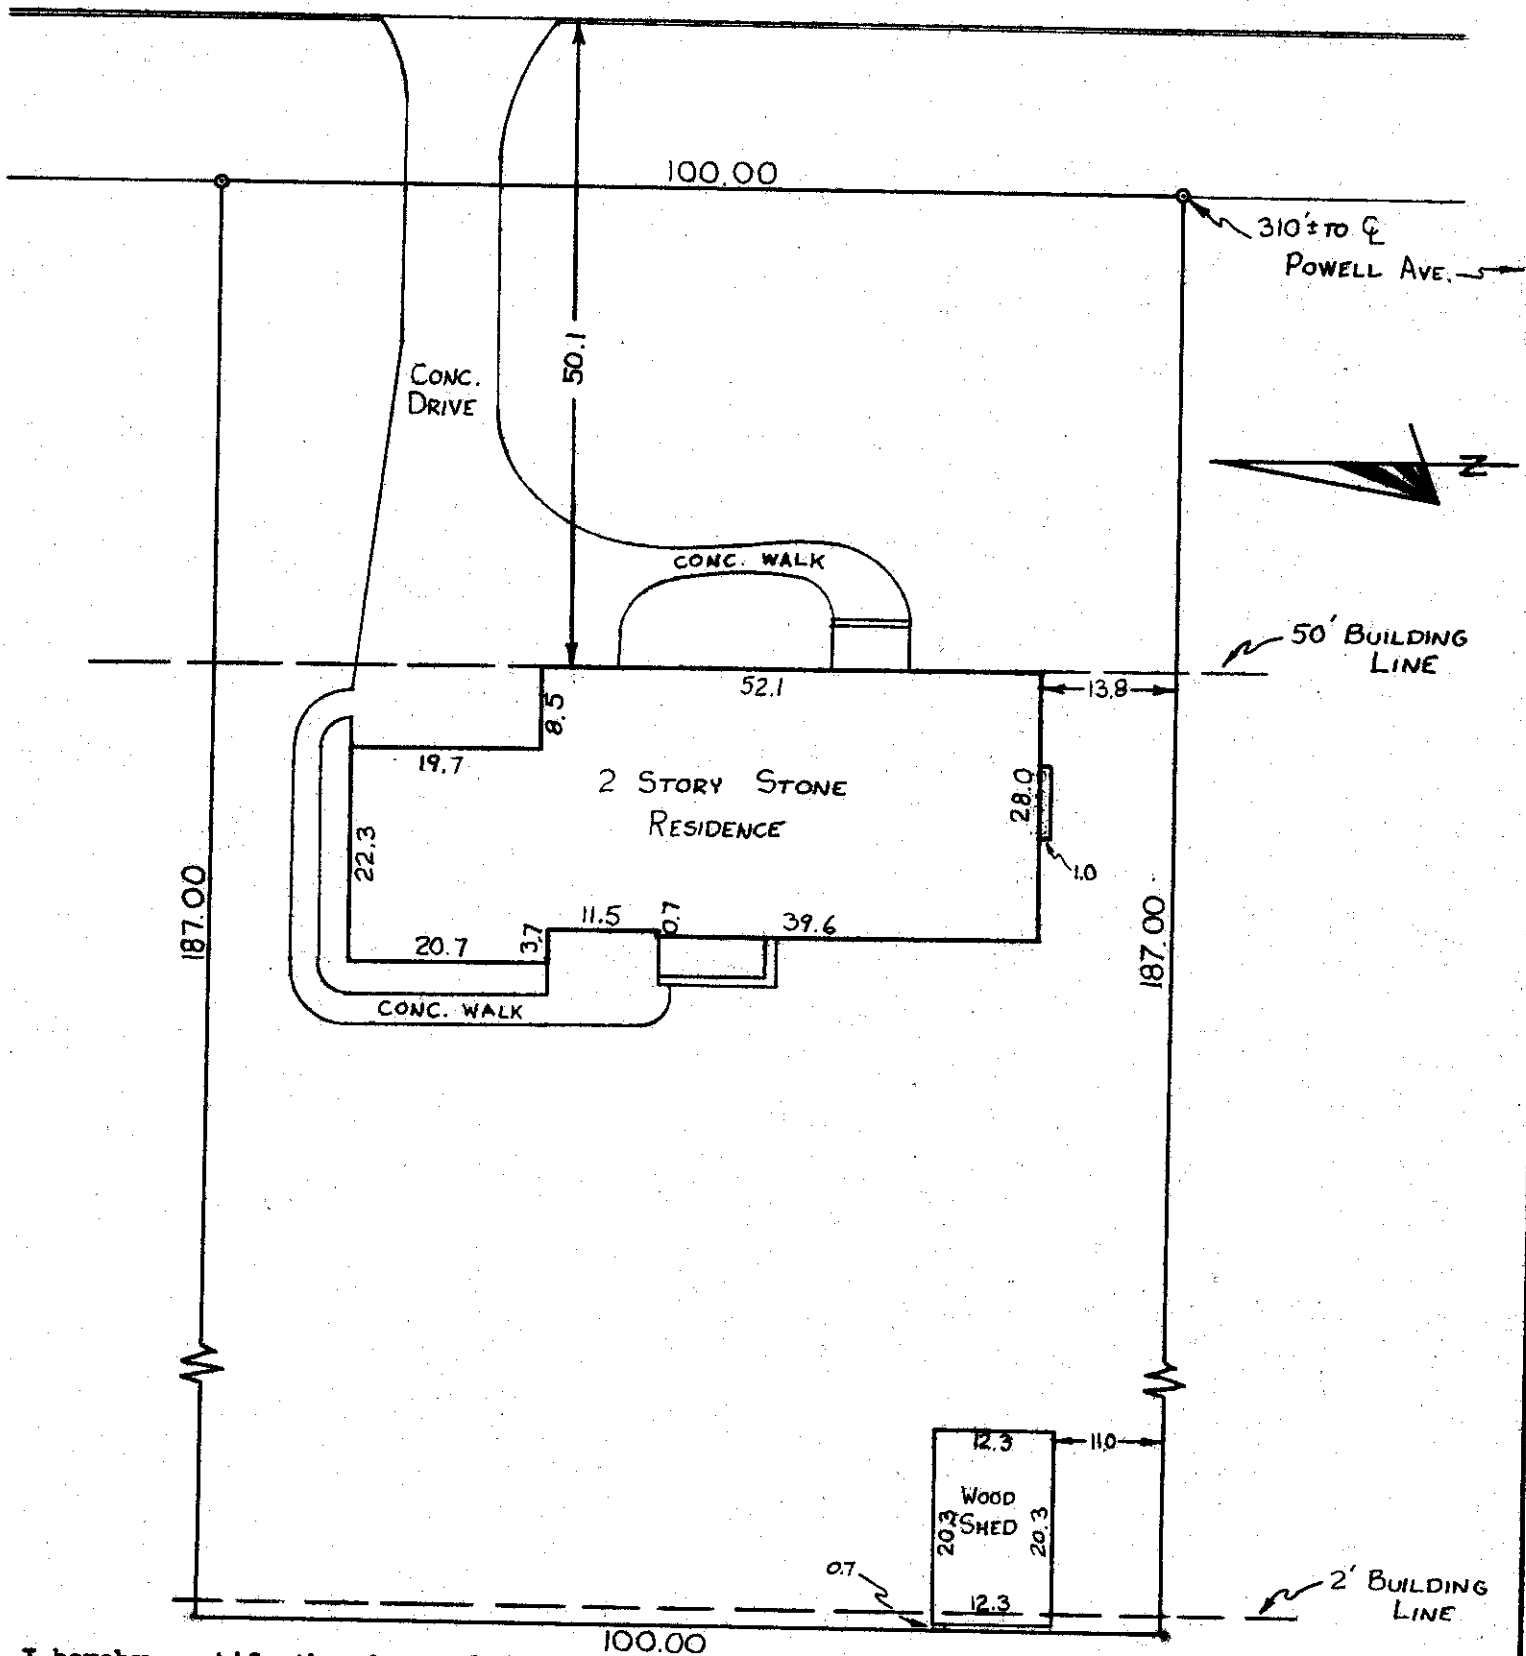

I hereby certify the above plat has been prepared from actual survey of the premises for use in mortgage loan and title purposes only. No sideline of principal building is less than dimension shown. Property corners not located unless shown thus -o-.

Harry L. Greene
 Harry L. Greene, Registered Surveyor, No. 4058