


Harry L. Greene, Surveyor

2160 Tremont Center, Columbus, Ohio 43221

To: State Savings Bank
Commonwealth Title Agency, Inc.,
Re: Gary E. and Eva L. Hignite
Being Lot No. 10, Perry Highlands, City of Worthington, Ohio.
6959 Perry Drive

PB. 63 Page 77 Recorders Office, _____ County, Ohio.
Scale 1" = 20' Date MARCH 10 1987

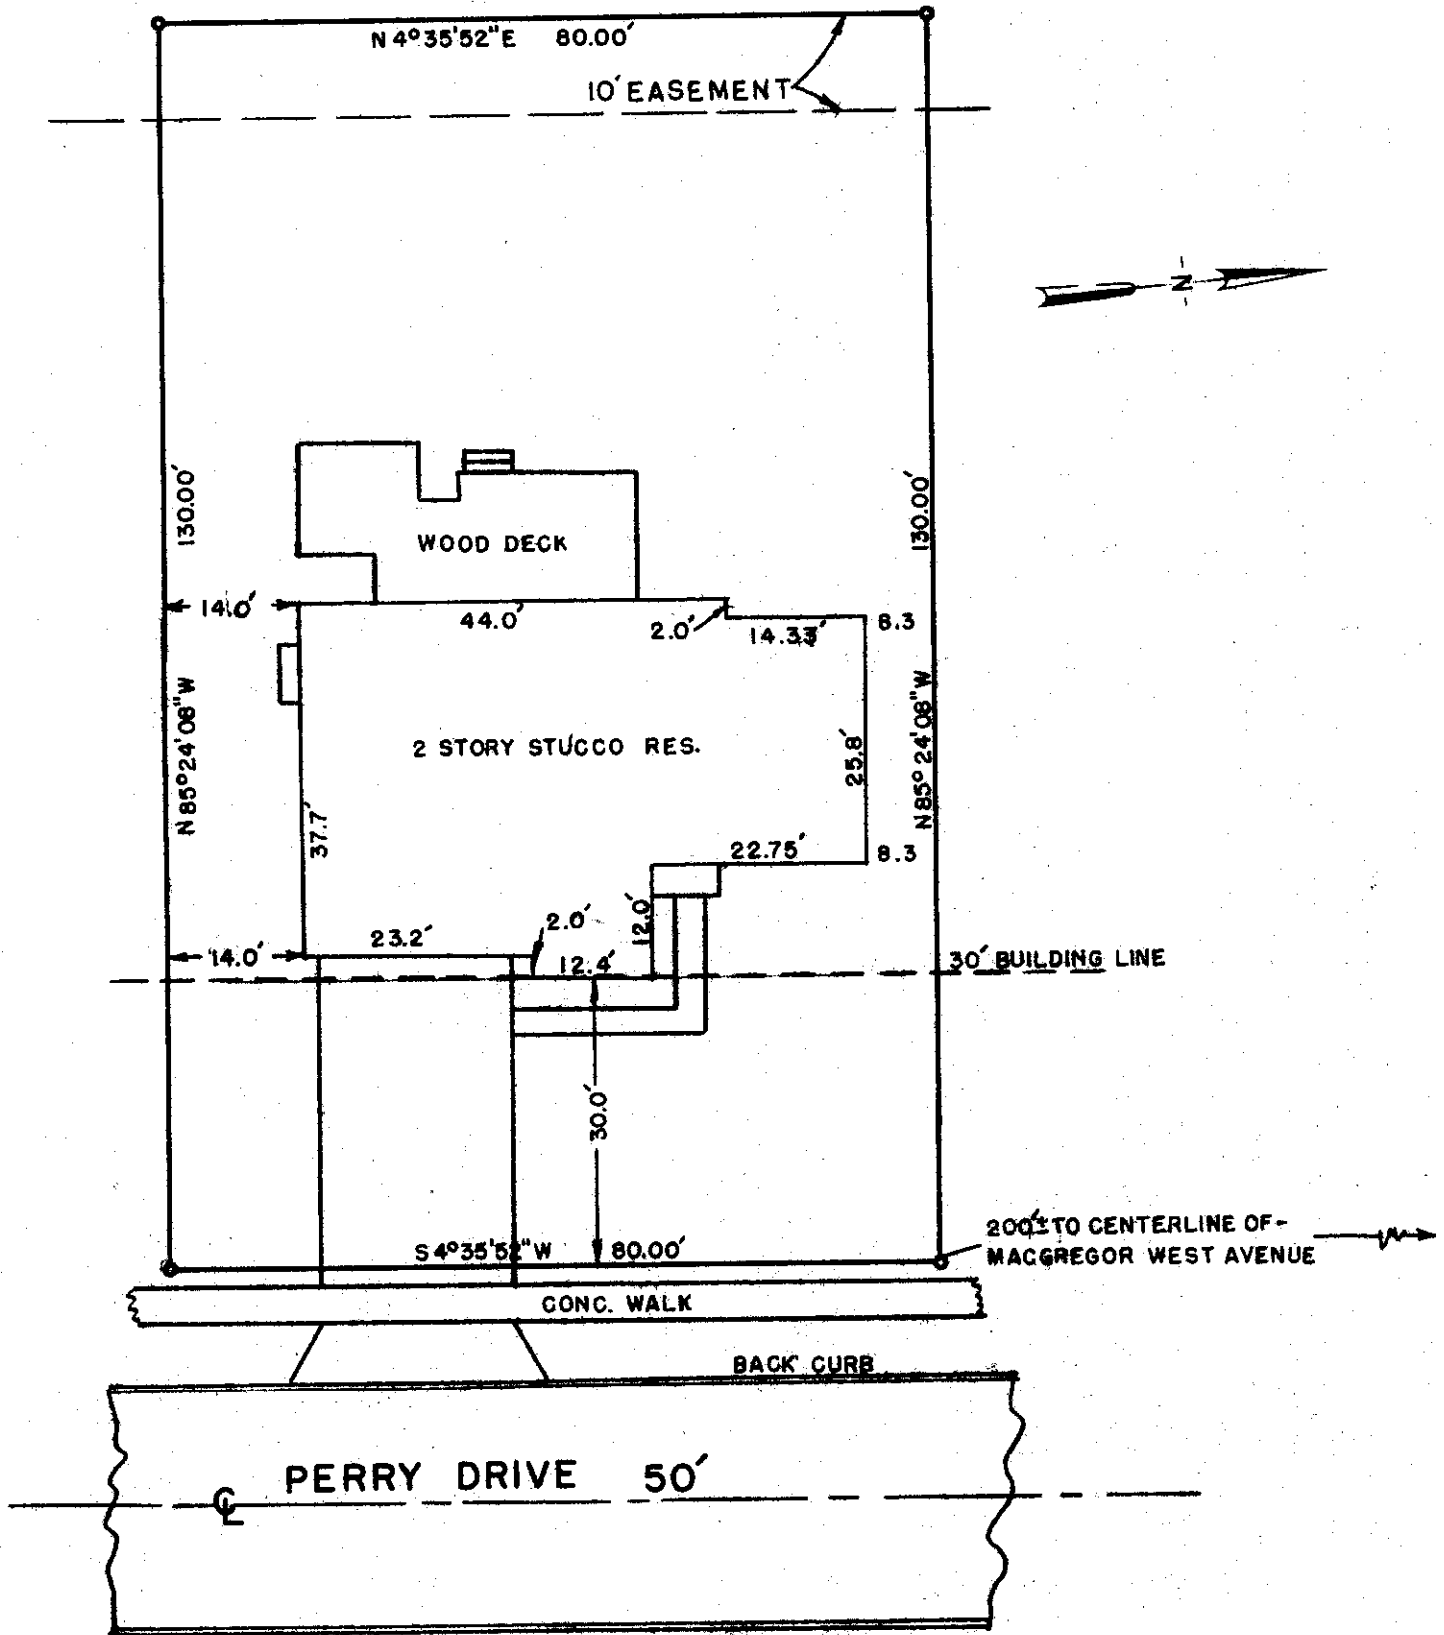

I hereby certify the above plat has been prepared from actual survey of the premises for use in mortgage loan and title purposes only. No sideline of principal building is less than dimension shown. Property corners not located unless shown thus -o-.

Harry L. Greene
Harry L. Greene, Registered Surveyor, No. 4058