

Harry L. Greene, Surveyor


2160 Tremont Center, Columbus, Ohio 43221

To: Chicago Title Agency of Central Ohio, Inc.,
County Savings Bank.

Being an 0.410 acre tract, City of Columbus, Franklin County,
Ohio,
3777 Livingston Avenue.

PB. _____ Page _____ Recorders Office, _____ County, Ohio.

Scale 1" = 30' Date January 20, 1987

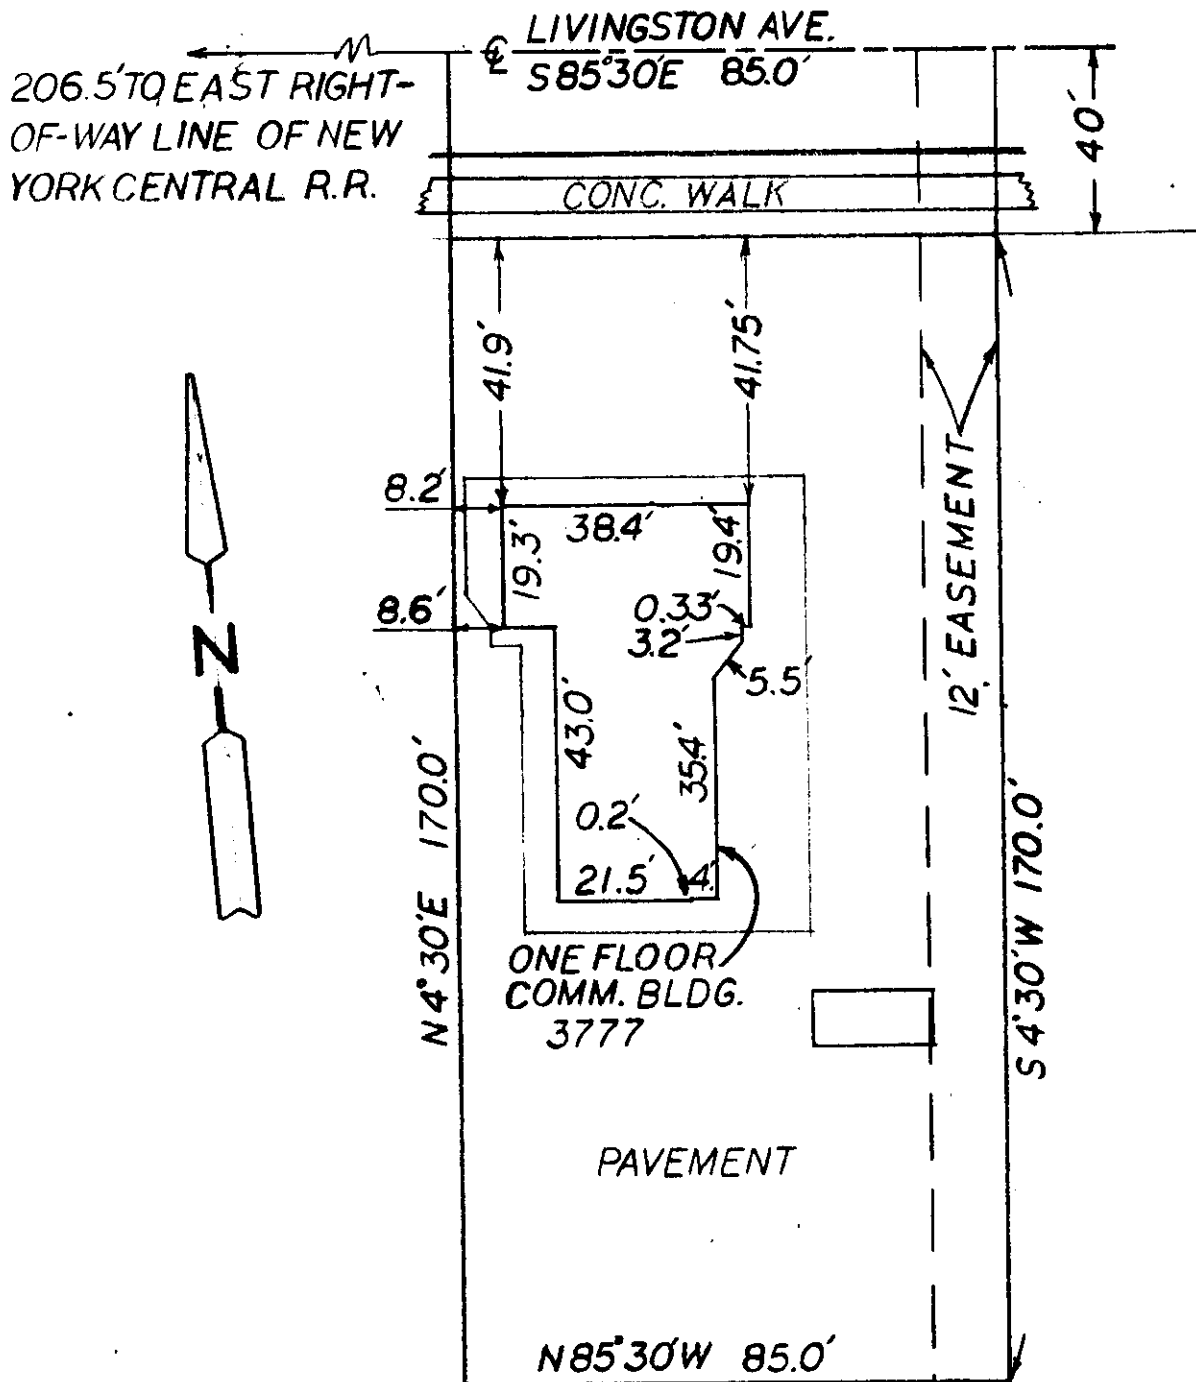

I hereby certify the above plat has been prepared from actual survey of the premises for use in mortgage loan and title purposes only. No sideline of principal building is less than dimension shown. Property corners not located unless shown thus -o-.

Harry L. Greene
Harry L. Greene, Registered Surveyor, No. 4058