


# Harry L. Greene, Surveyor

2160 Tremont Center, Columbus, Ohio 43221

TO: Heritage Land Title Agency.  
Mid America Federal Savings & Loan Association.  
RE: Mike Milosh.  
401-402 Catherine St.

PB. 7 Page 208 Recorders Office, Franklin County, Ohio.  
Scale  $1'' = 10'$  Date January 7, 1987

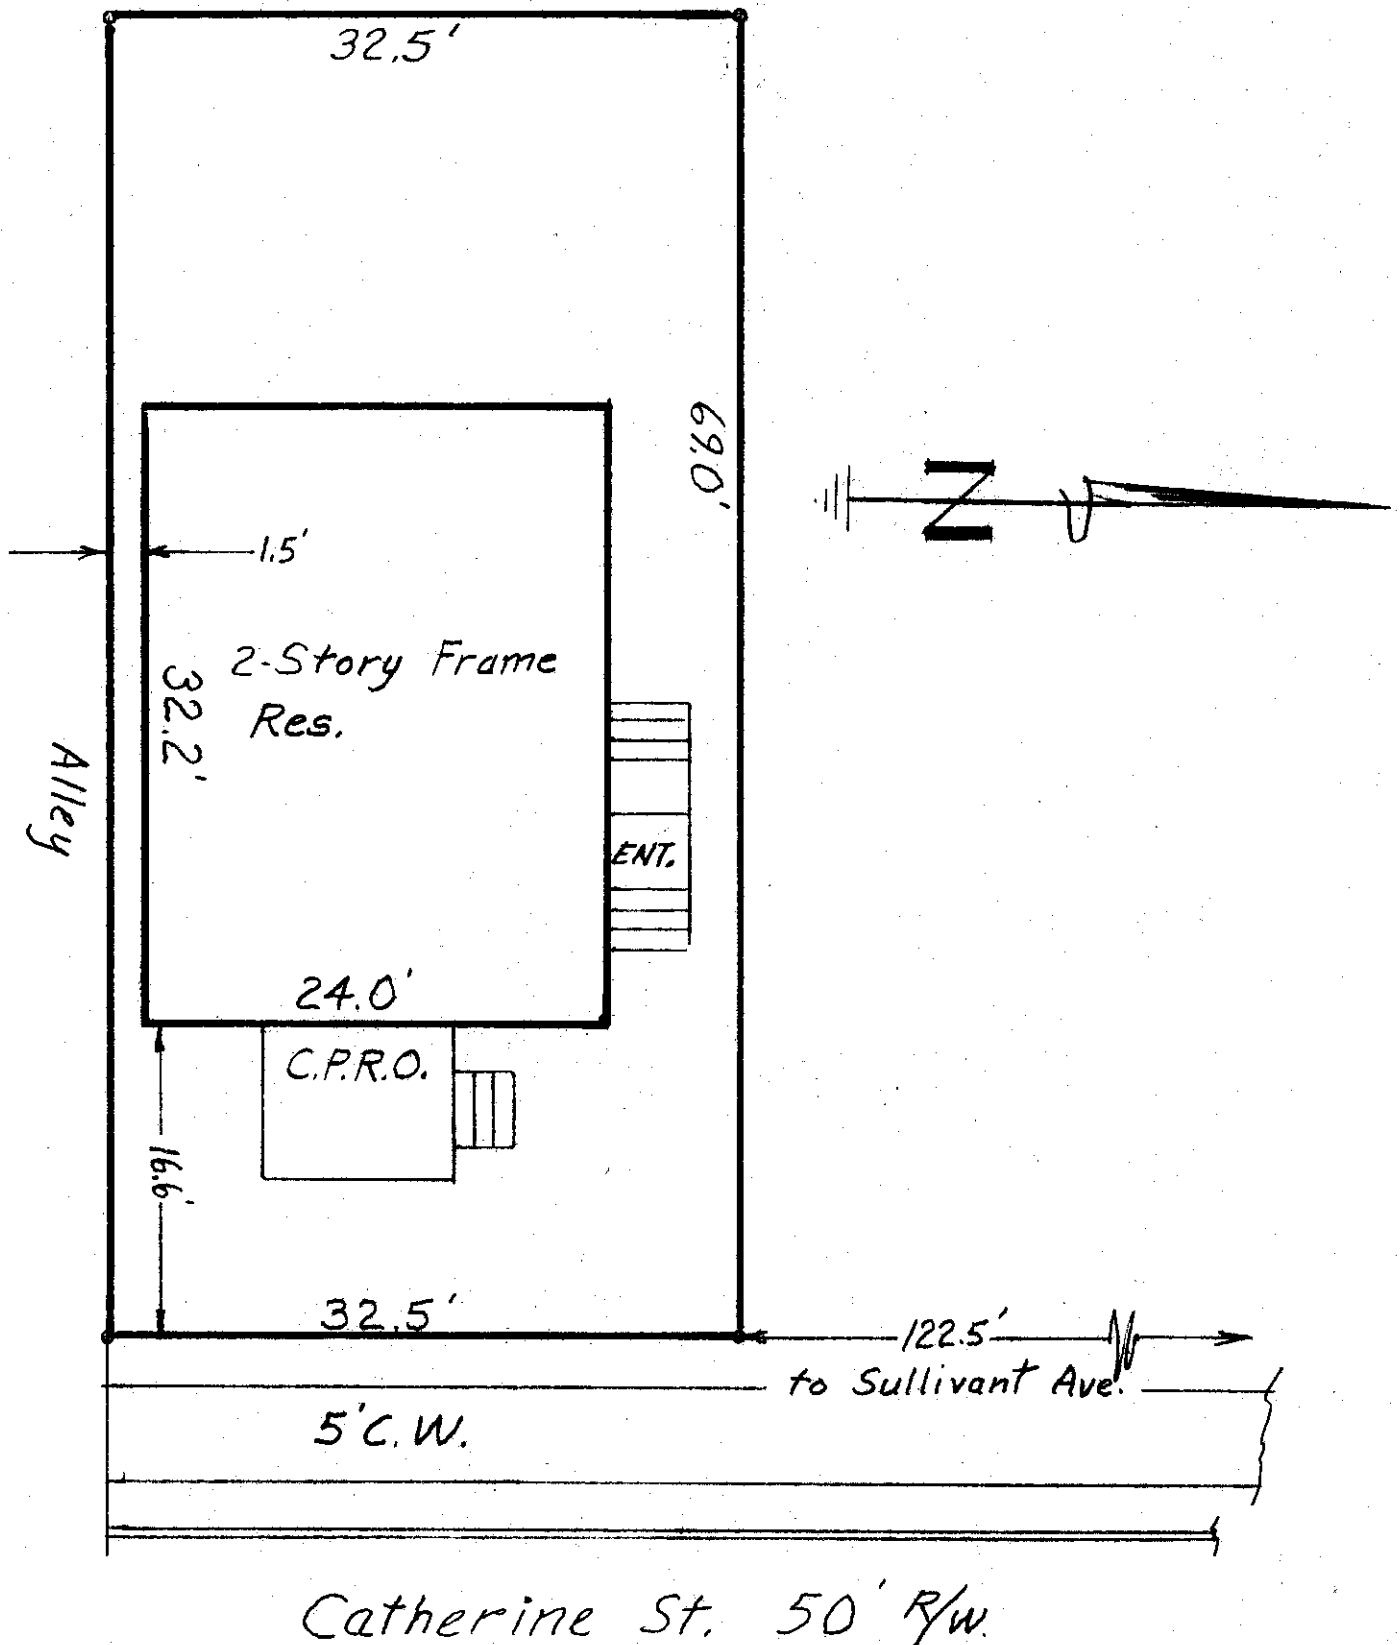

I hereby certify the above plat has been prepared from actual survey of the premises for mortgage loan and title purposes. The outline of principal building is as shown. Property corners are as shown unless shown thus -o-.

*Harry L. Greene*  
Harry L. Greene, Registered Surveyor, No. 4058