


# Harry L. Greene, Surveyor

2160 Tremont Center, Columbus, Ohio 43221

PLAT SHOWING SURVEY OF LOT NO. 101 OF RICKETTS AND ADY'S FAIRDAY ADDITION, 1293 AVONDALE AVENUE, CITY OF GRANDVIEW HEIGHTS, FRANKLIN COUNTY, OHIO.

For Barbara Shea.

PB. 4 Page 278 Recorders Office, Franklin County, Ohio.  
Scale 1" = 20' Date September 7, 1988

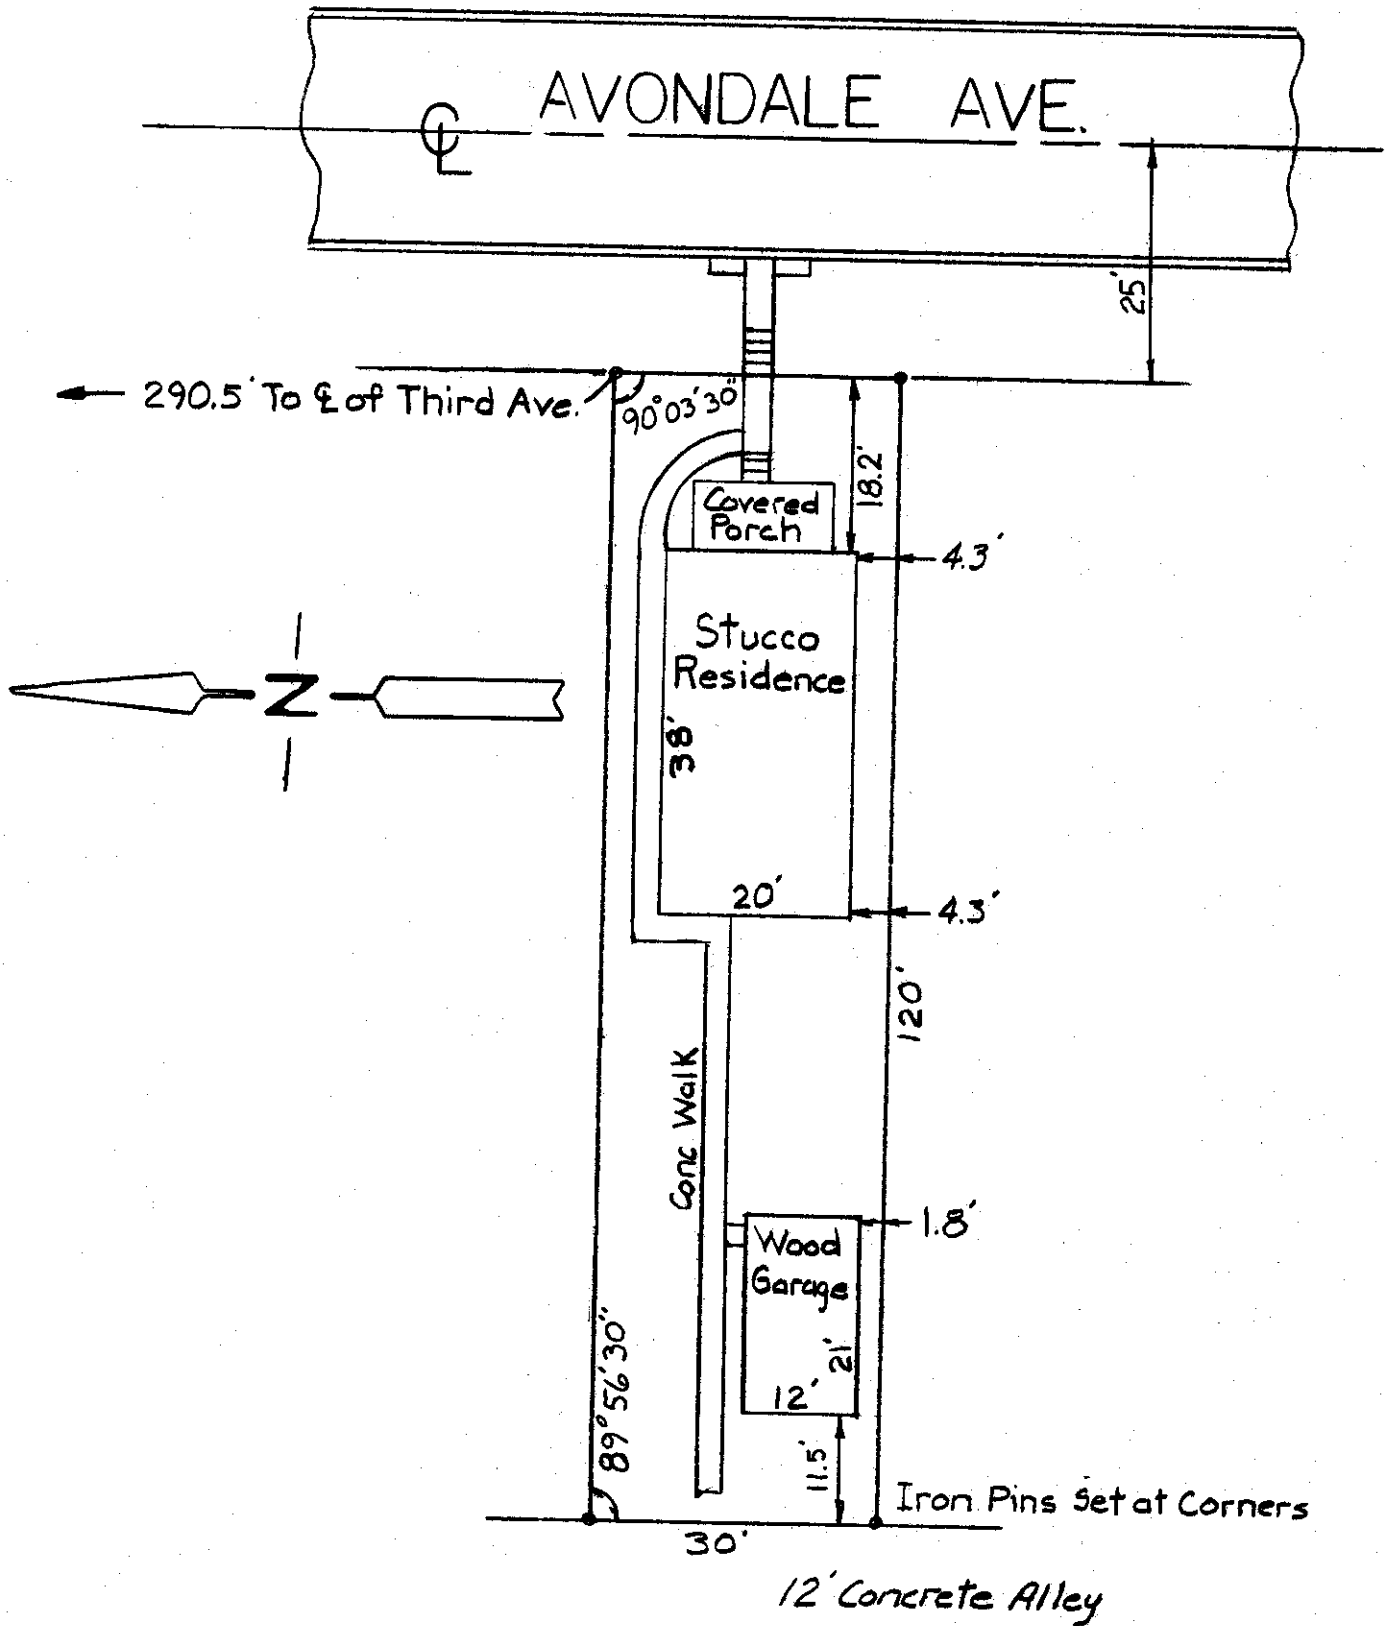

I hereby certify the above plat has been prepared from actual survey of the premises for use in mortgage loan and title purposes only. No sideline of principal building is less than dimension shown. Property corners not located unless shown thus -o-.

*Harry L. Greene*  
Harry L. Greene, Registered Surveyor, No. 4058