

Harry L. Greene, Surveyor



2160 Tremont Center, Columbus, Ohio 43221

To: Bank One, Dover, N.A.
Ohio Bar Title Insurance Company

Re: Sunbrite Car Washes, Inc.

See legal description attached hereto and hereby made a part of this survey.

PB. _____ Page _____ Records Office, Franklin County, Ohio.
Scale 1" = 30 Date August 26, 1988

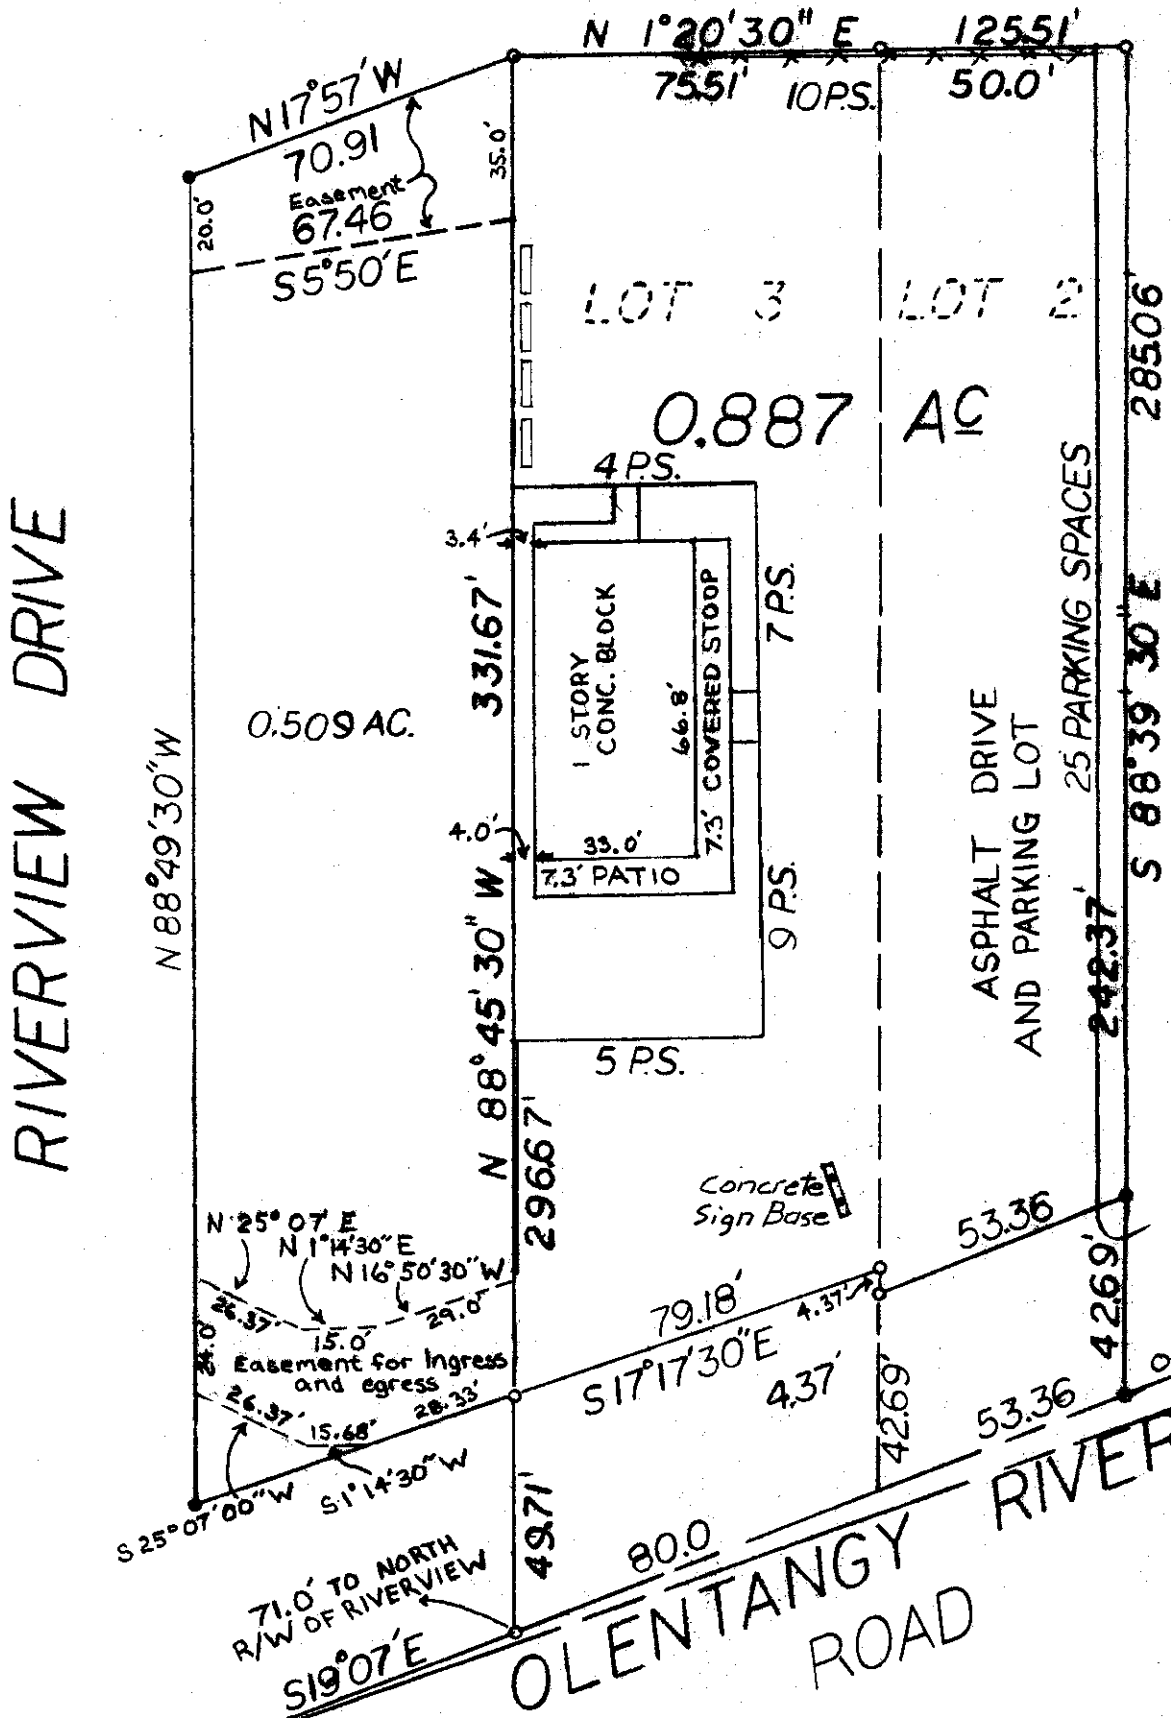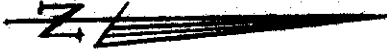

I hereby certify the above plat has been prepared from actual survey of the premises for use in mortgage loan and title purposes only. No sideline of principal building is less than dimension shown. Property corners not located unless shown thus -o-.

Harry L. Greene, Registered Surveyor, No. 4058