


Harry L. Greene, Surveyor

2160 Tremont Center, Columbus, Ohio 43221

PLAT SHOWING SURVEY OF LOT NO 9 JOSEPH SAUER'S SUBDIVISION,
OF RECORD IN PLAT BOOK 5 PAGE 84, Recorder's Office, Franklin,
County, Ohio

PB. _____ Page _____ Records Office, _____ County, Ohio.
Scale 1" = 30 Date August 16, 1988

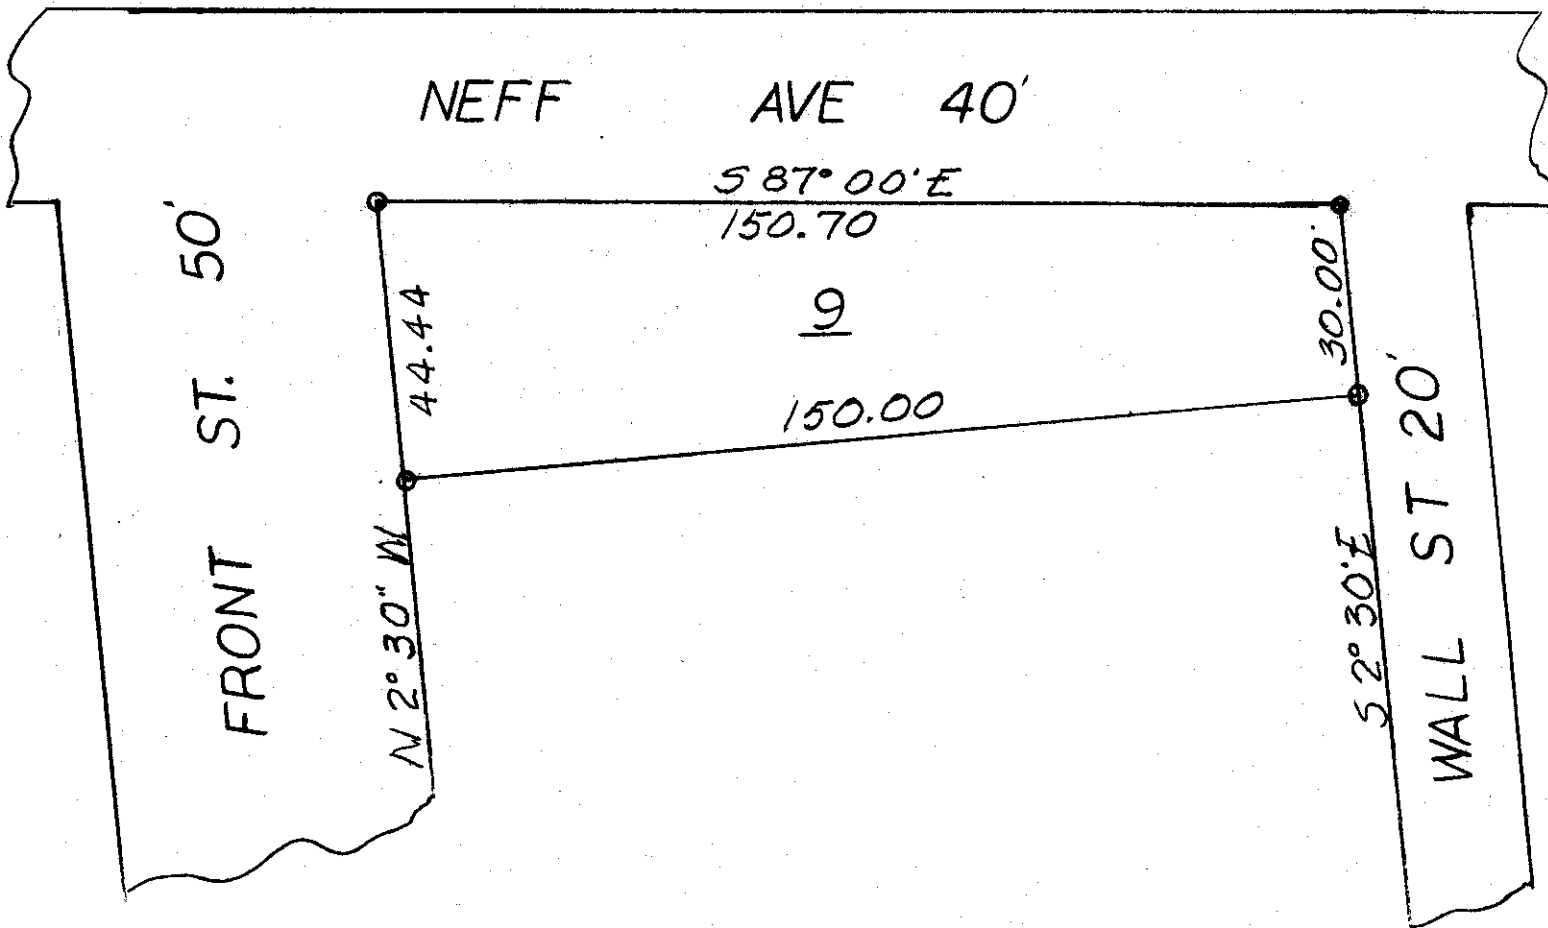

I hereby certify the above plat has been prepared from actual survey of the premises.

Harry L. Greene
Harry L. Greene, Registered Surveyor, No. 4058