


Harry L. Greene, Surveyor

2160 Tremont Center, Columbus, Ohio 43221

PLAT SHOWING BOUNDARY AND LOCATION SURVEY OF LOT NO. 54, SCIOTO TRACE, SECTION 2, City of Columbus, Franklin County, Ohio.

For: Mr. Mike Jacobs

PB. 56 Page 11 Recorders Office, FRANKLIN County, Ohio.
Scale 1" = @) Date August 18, 1988

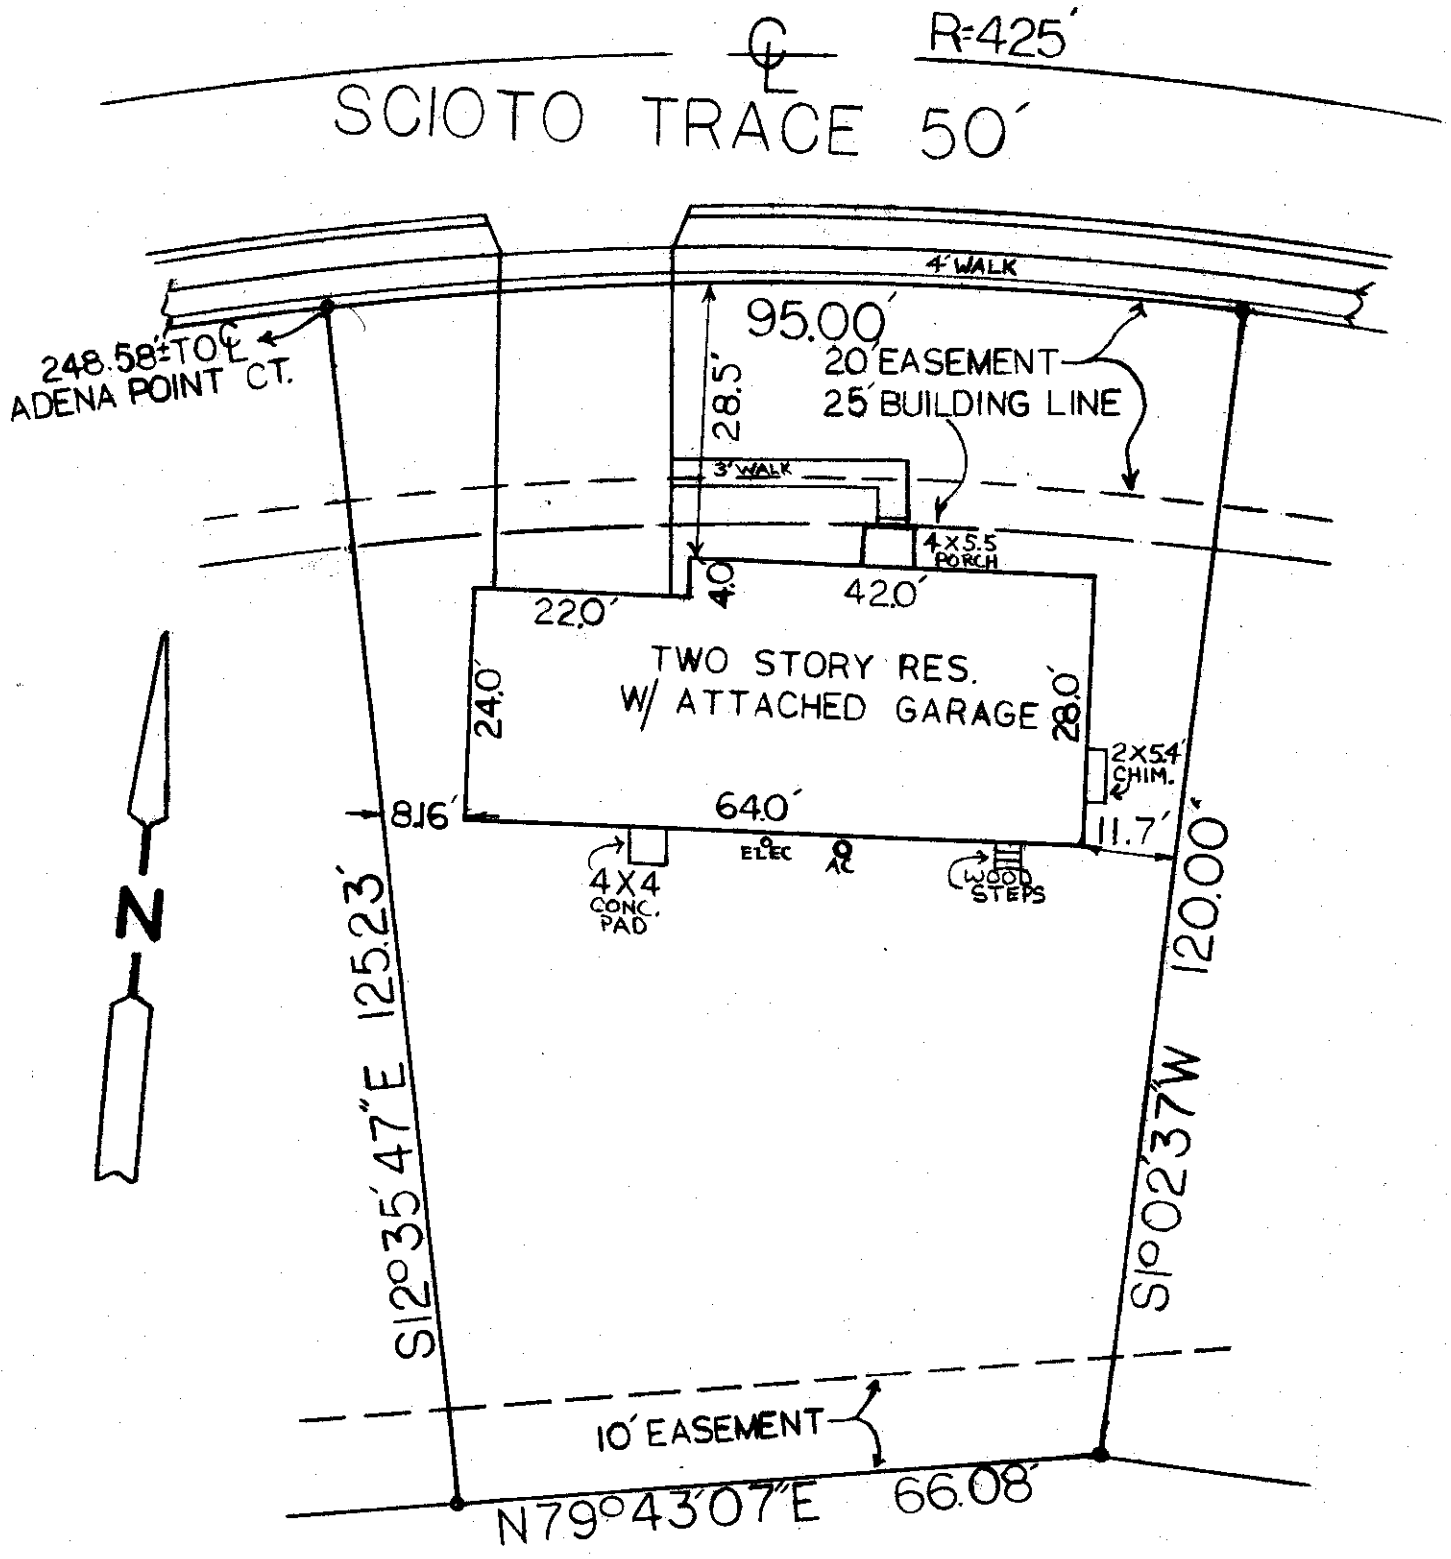

I hereby certify the above plat has been prepared from actual survey of the premises for use in mortgage loan and title purposes only. No sideline of principal building is less than dimension shown. Property corners not located unless shown thus -o-.

Harry L. Greene
Harry L. Greene, Registered Surveyor, No. 4058