

# Harry L. Greene, Surveyor

2160 Tremont Center, Columbus, Ohio 43221

For: CHICAGO TITLE AGENCY OF CENTRAL OHIO, INC.  
and/or


BUCKEYE FEDERAL SAVINGS & LOAN ASS'N.

Re: Lane Avenue Baptist Church

Lot No. 3 and 31.38 off the north end of lot 2

PB. \_\_\_\_\_ Page \_\_\_\_\_ Recorders Office, \_\_\_\_\_ County, Ohio.  
Scale 1" = \_\_\_\_\_ Date \_\_\_\_\_

The undersigned also hereby certifies that this tract of land does not lie within a flood hazard area, in accordance with the document entitled "Department of Housing and Urban Development, Federal Insurance Administration Special Flood Hazard Area Maps" and is in Zone "C", City of Upper Arlington Flood Insurance Rate Map, Panel No. 390178 0003B Dated April 15, 1980.

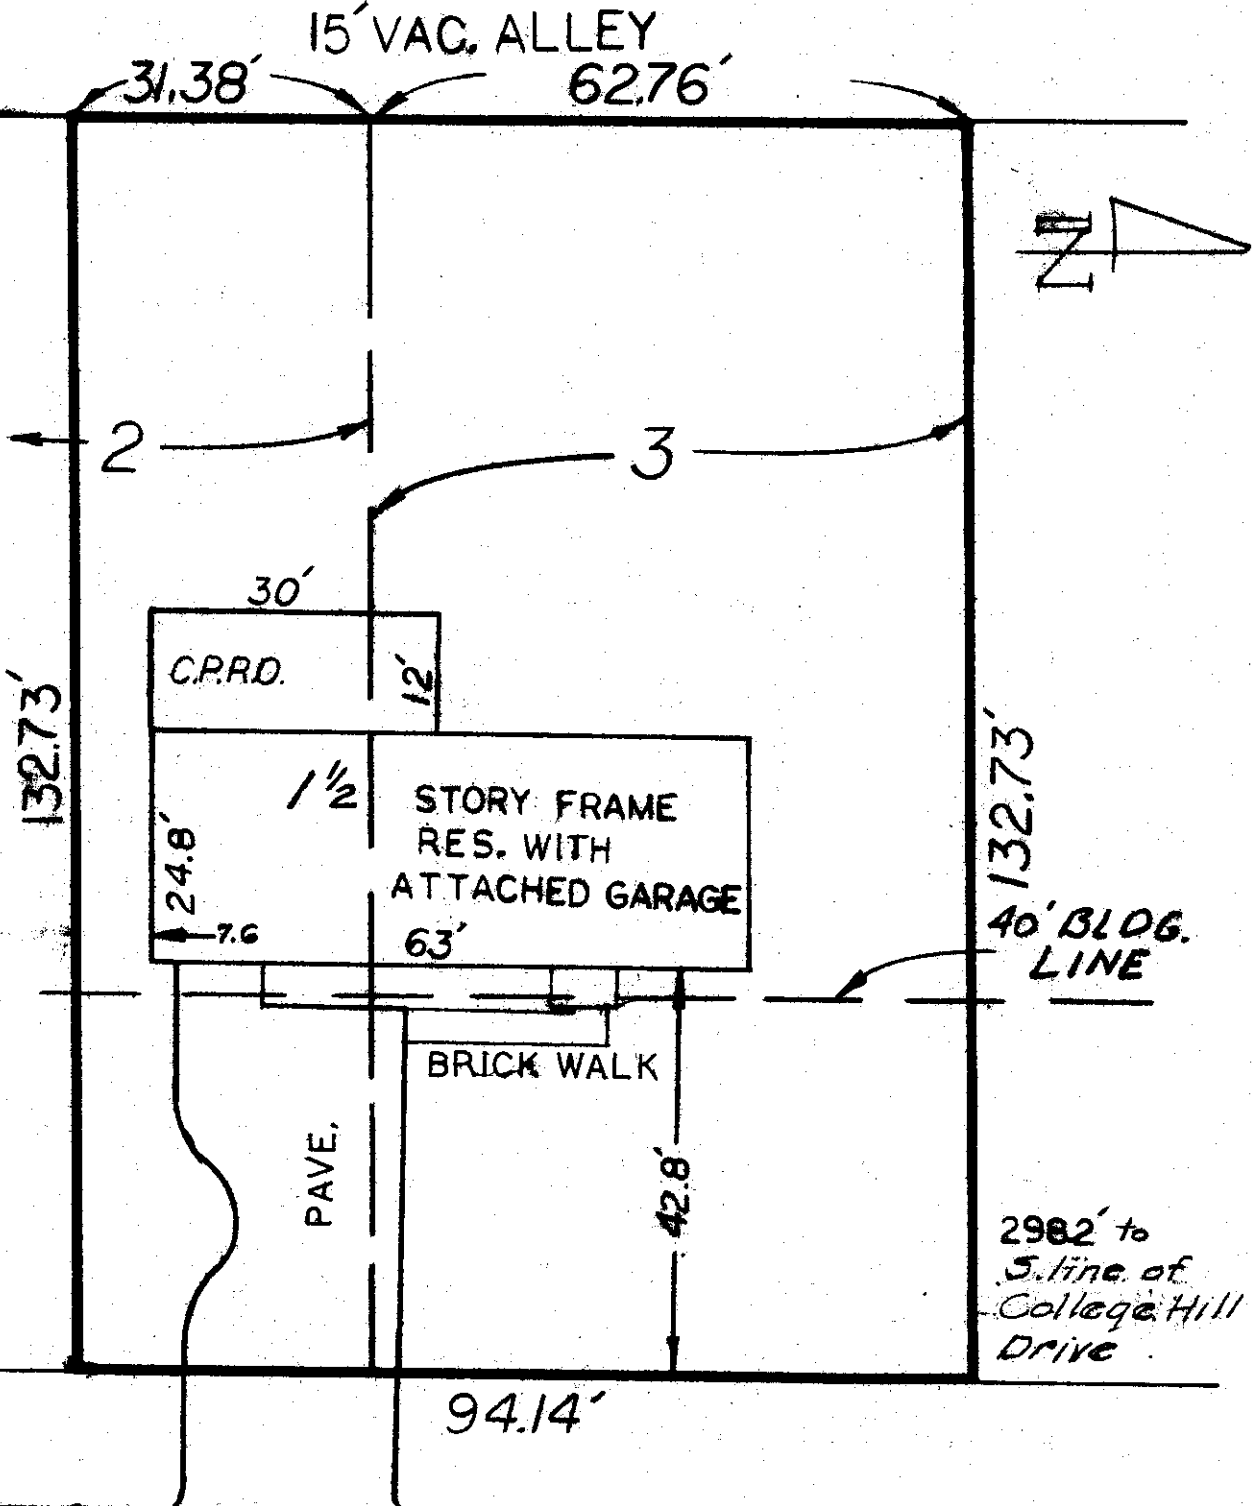

M.T. HOLYOKE ROAD 50'

I hereby certify the above plat has been prepared from actual survey of the premises for use in mortgage loan and title purposes only. No sideline of principal building is less than dimension shown. Property corners not located unless shown thus -o-.

*Harry L. Greene*  
Harry L. Greene, Registered Surveyor, No. 4058