Harry L. Greene, Surveyor

2160 Tremont Center, Columbus, Ohio 43221

PLAT SHOWING SURVEY OF 0.2675 ACRES SITUATED IN THE CITY OF COLUMBUS, FRANKLIN COUNTY, OHIO.

FOR: THE Huntington National Bank

P.B. 7 Page 63 Recorders Office, Franklin County, Ohio.
Scale 1" = 30 Date APRIL 25, 1988

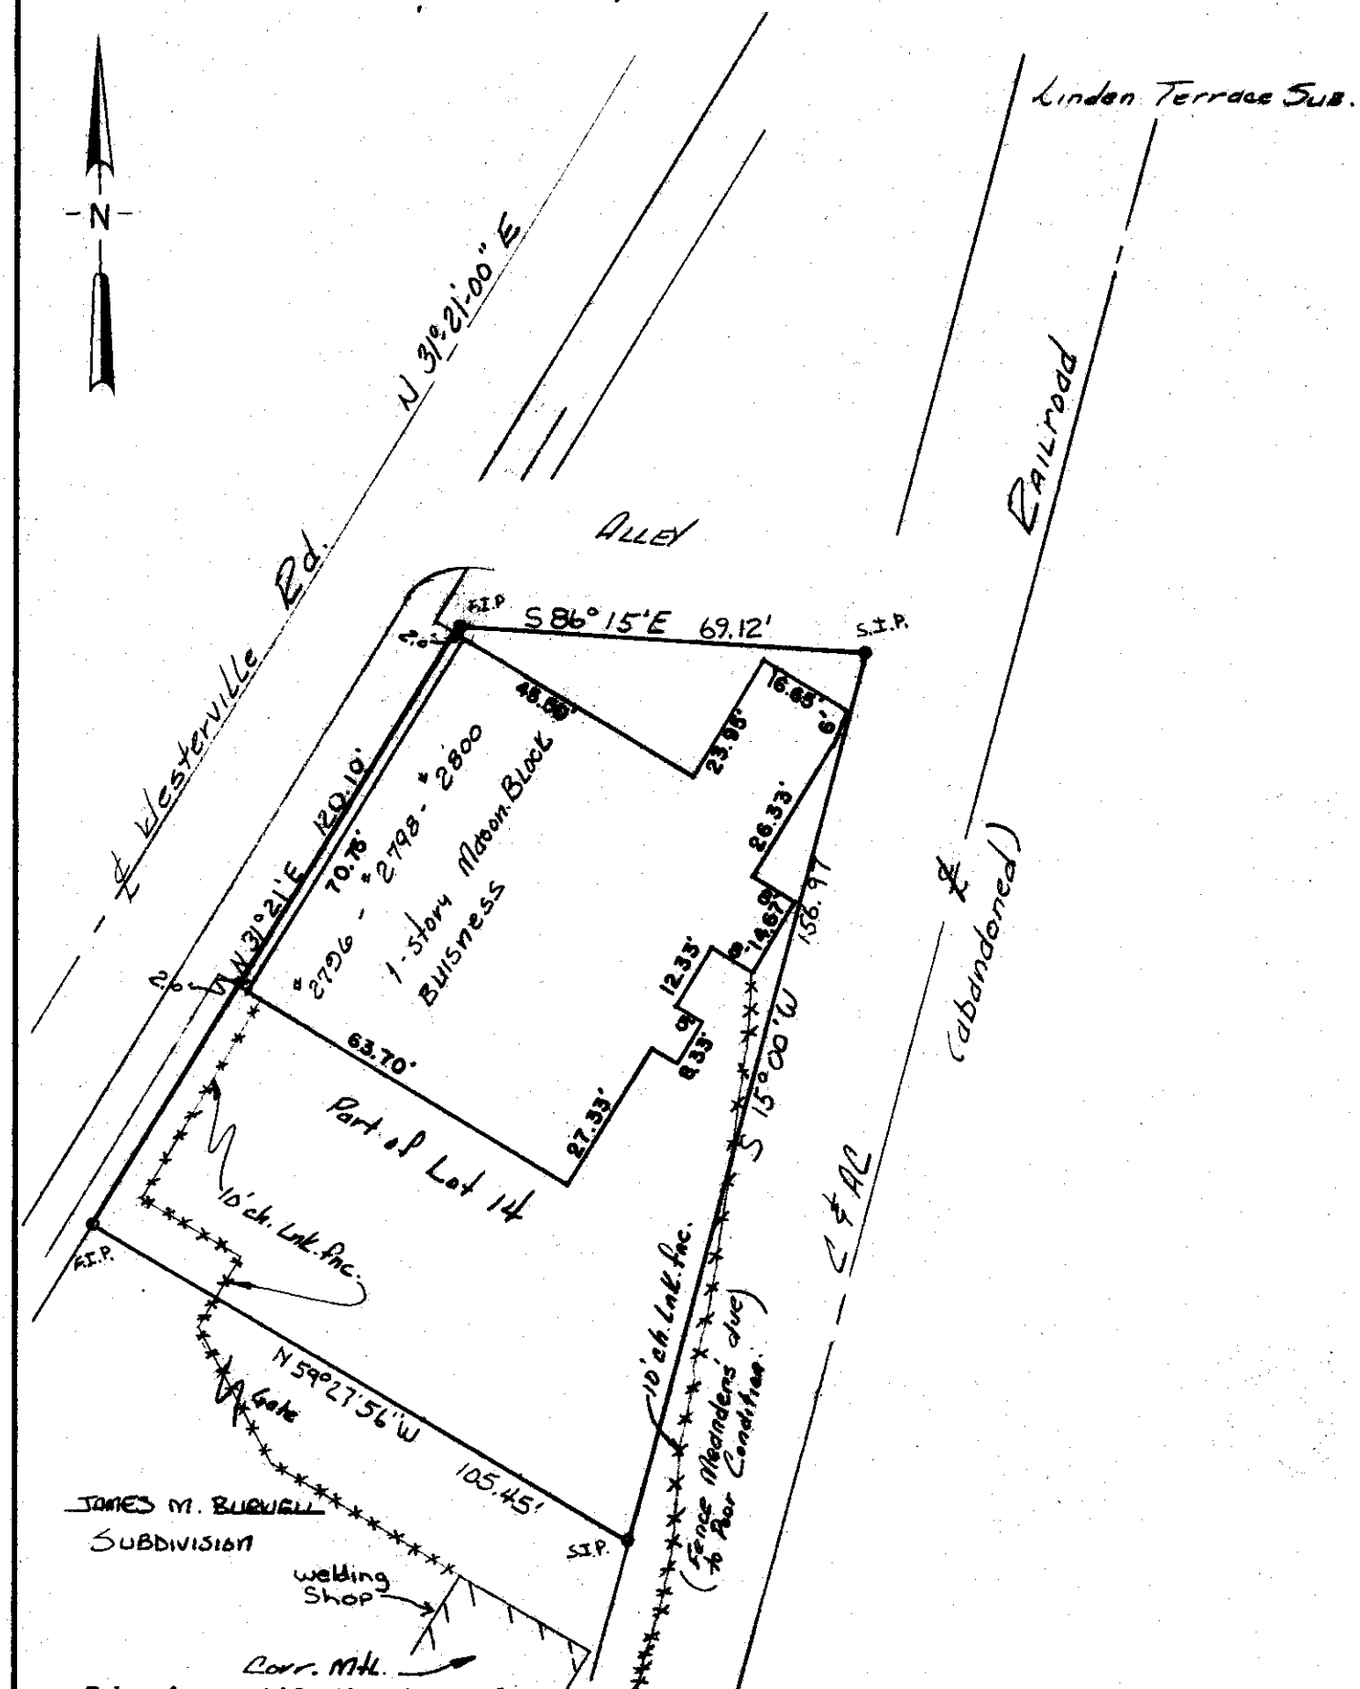

I hereby certify the above plat has been prepared from actual survey of the premises for use in mortgage loan and title purposes only. No sideline of principal building is less than dimension shown. Property corners not located unless shown thus -o-.

Charles R. Wolfe

~~Harry L. Greene~~, Registered Surveyor, No. ~~[illegible]~~ 6186

CHARLE R. WOLFE