


Harry L. Greene, Surveyor

2160 Tremont Center, Columbus, Ohio 43221

PLAT SHOWING SURVEY OF LOT NO. 95, TREMONT PLACE ADDITION
CITY OF UPPER ARLINGTON, FRANKLIN COUNTY, OHIO.

For Ruth Morgan.

PB. _____ Page _____ Records Office, Franklin County, Ohio.
Scale 1" = 20' Date March 28, 1988

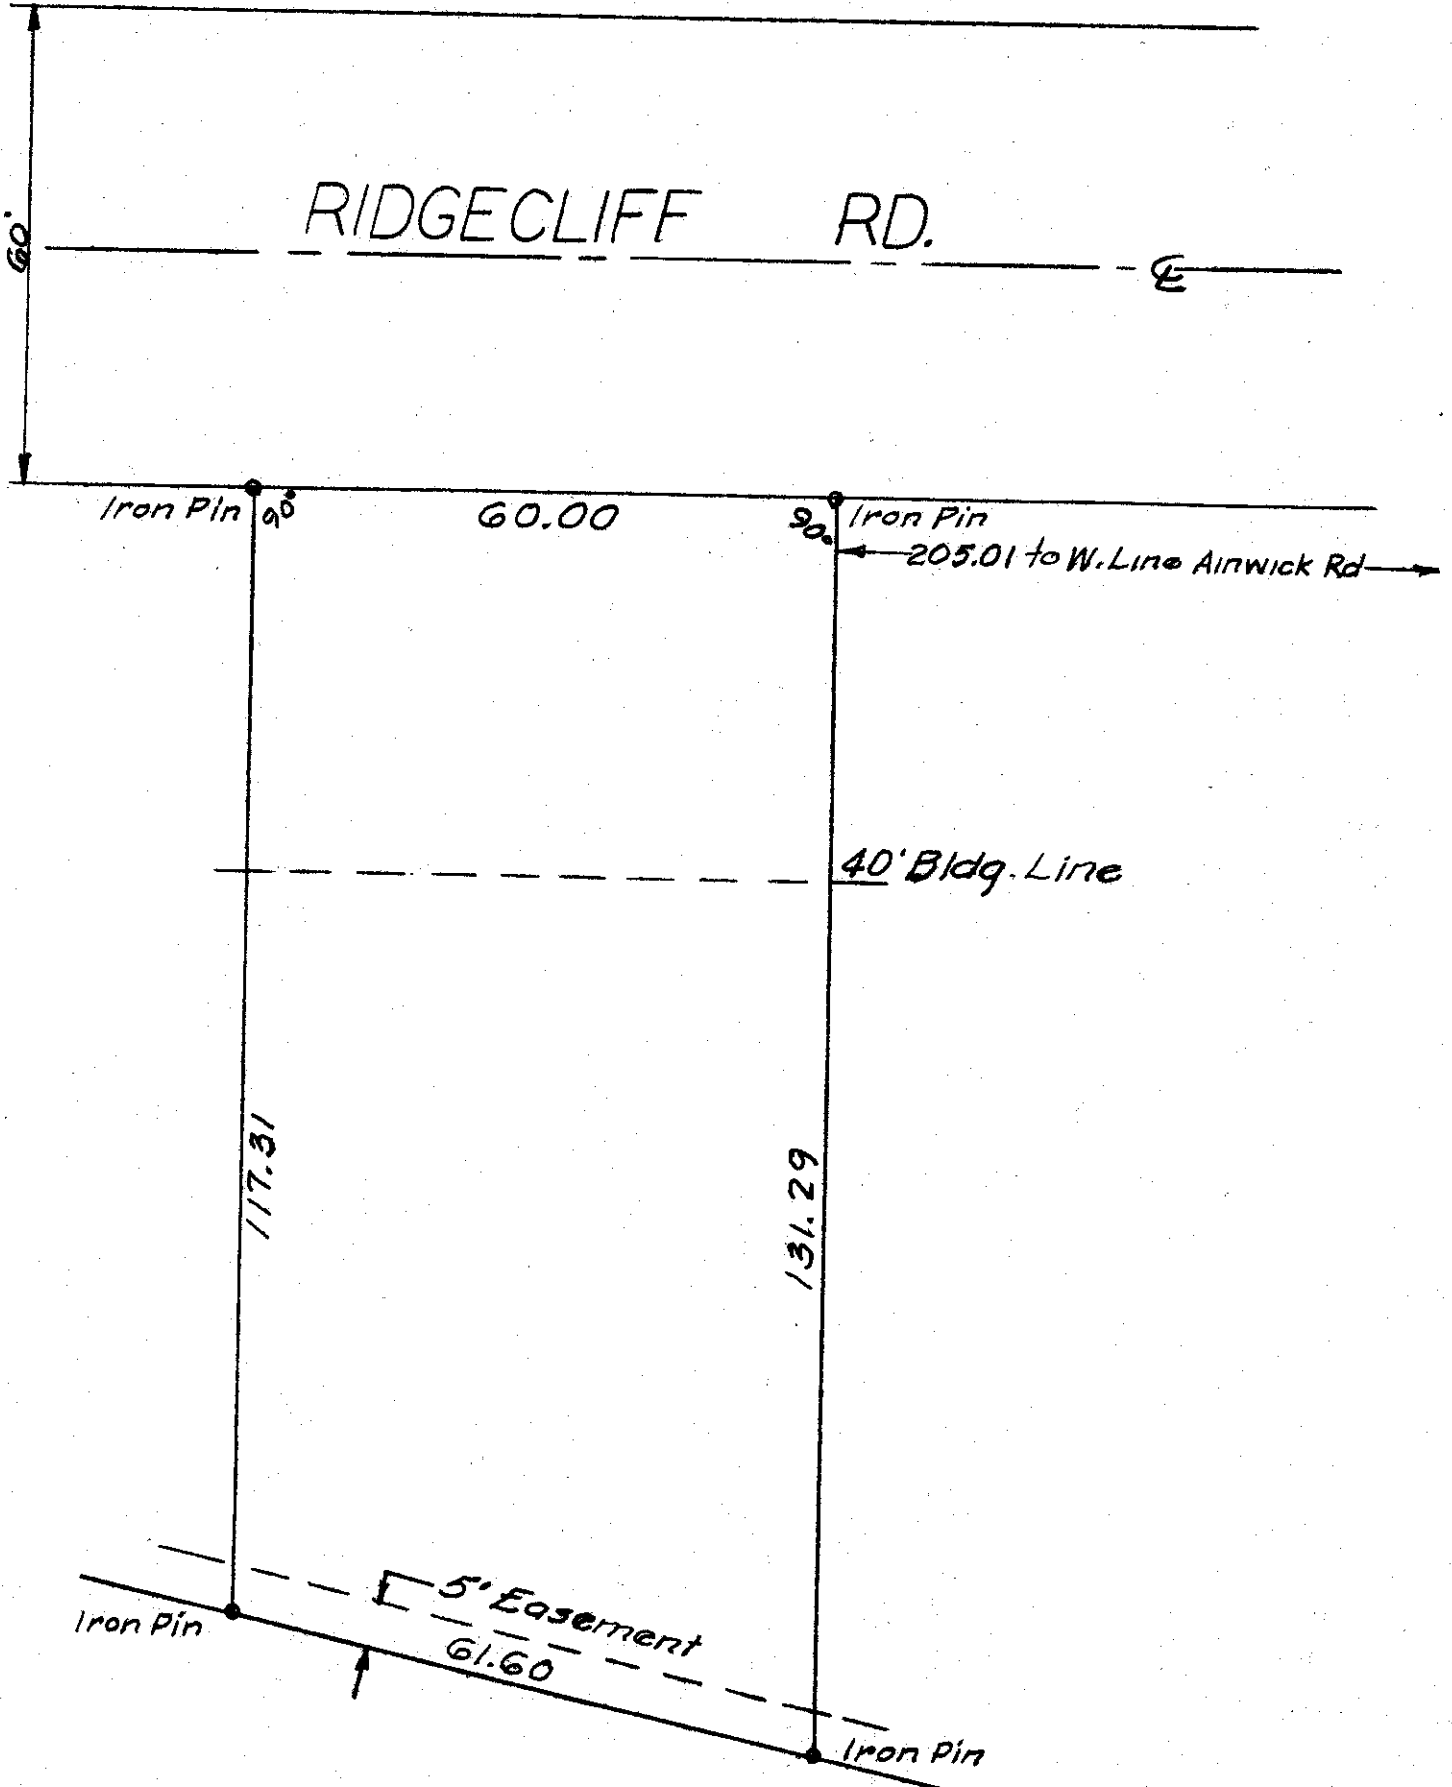

I hereby certify the above plat has been prepared from actual survey of the premises

Harry L. Greene
Harry L. Greene, Registered Surveyor, No. 4058