Harry L. Greene, Surveyor

2160 Tremont Center, Columbus, Ohio 43221

PLAT SHOWING SURVEY OF LOT NO. 13, BLOCK 407, FISHINGER PARK ADDITION, AS SHOWN OF RECORD IN PLAT BOOK 26, PAGE 36, RECORDER'S OFFICE, FRANKLIN COUNTY, OHIO.

For. Margaret Galbreath.

3950 Norbrook Drive, City of Upper Arlington, Ohio.

P.B. 26 Page 36 Recorders Office, Franklin County, Ohio.

Scale 1" = 20' Date August 23, 1989

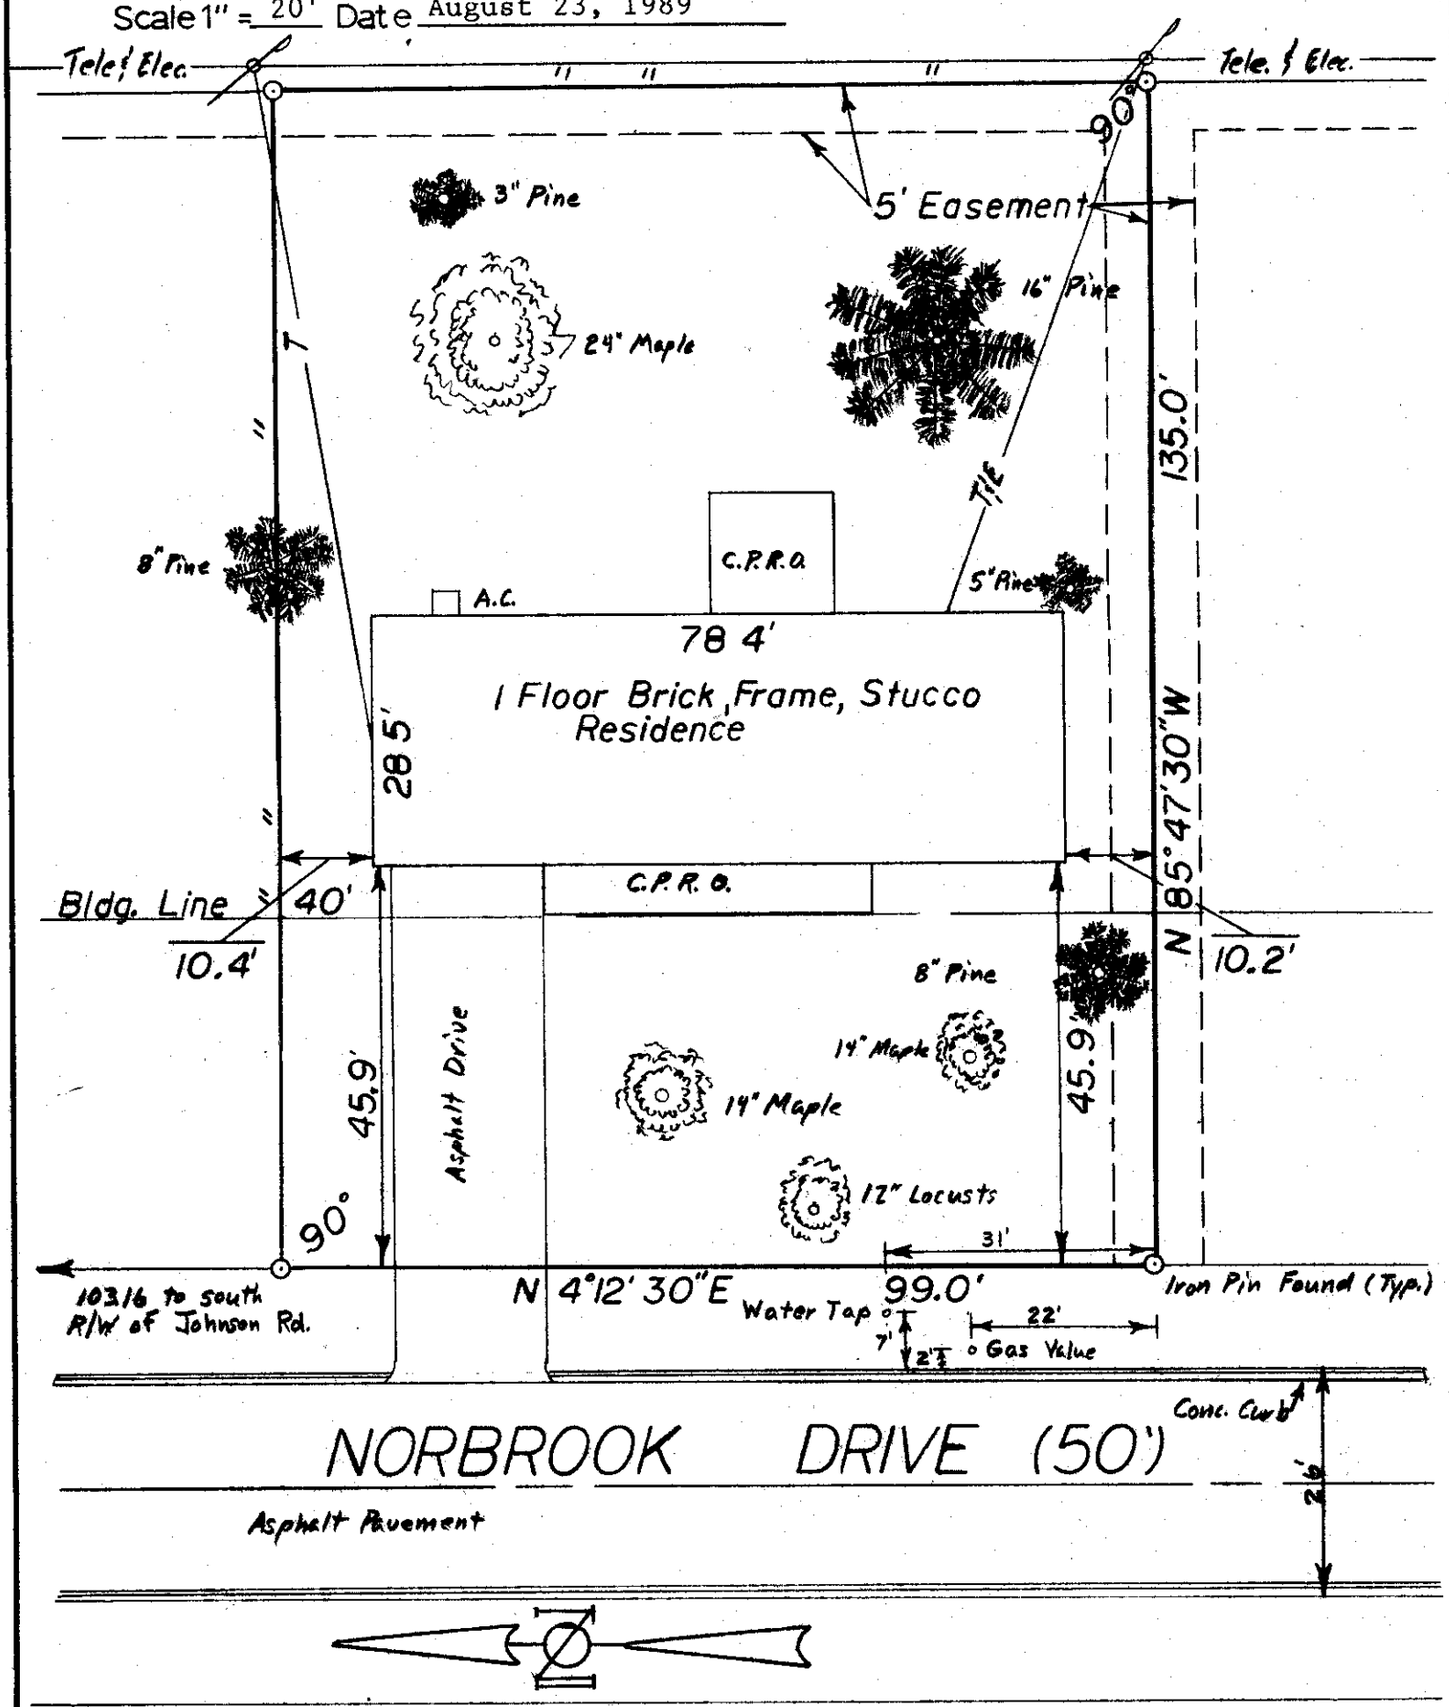

I hereby certify the above plat has been prepared from actual survey of the premises

Harry L. Greene

Harry L. Greene, Registered Surveyor, No. 4058