Harry L. Greene, Surveyor

2160 Tremont Center, Columbus, Ohio 43221

To: State Savings Bank

Re: S. Robert Davis,

Being Lot No. 4, of GALWAY ESTATES SJBDIVISION, Plat Book 59, Page 55, Recorder's Office, FranklinCounty, Ohhio.

P.B. ____ Page ____ Recorders Office, FRANKLIN County, Ohio.
Scale 1" = 50' Date April 28, 1989

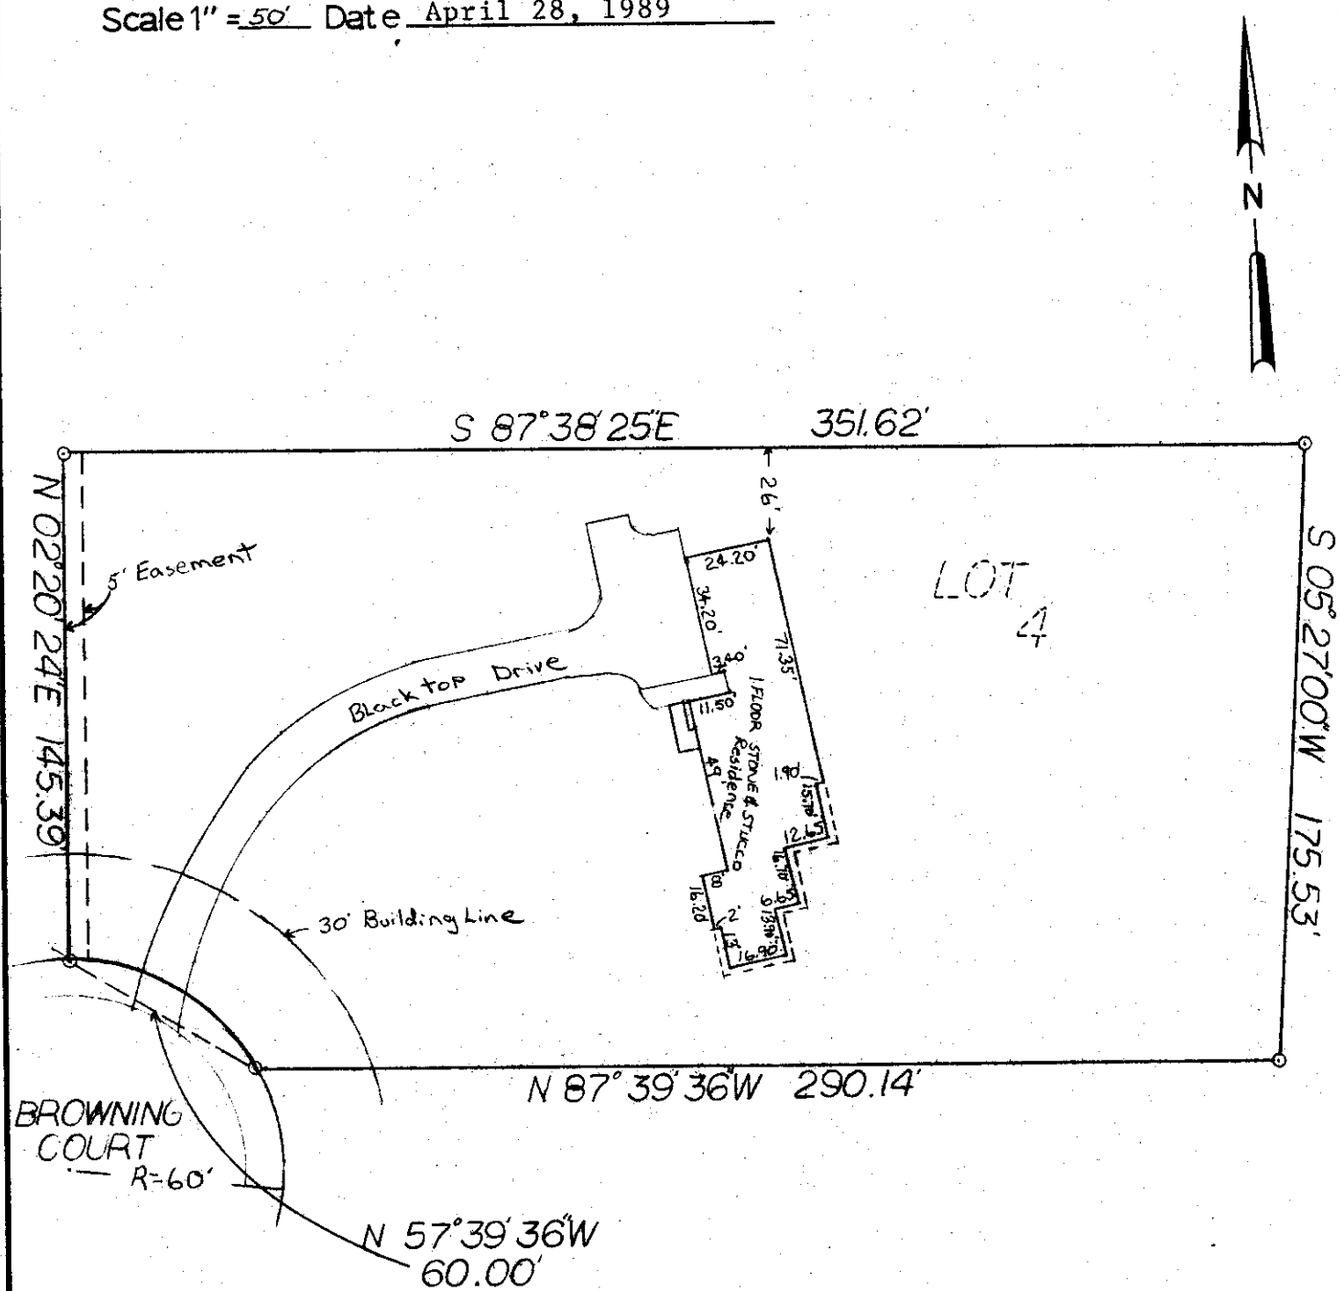

I hereby certify the above plat has been prepared from actual survey of the premises for use in mortgage loan and title purposes only. No sideline of principal building is less than dimension shown. Property corners not located unless shown thus -o-.

Harry L. Greene

Harry L. Greene, Registered Surveyor, No. 4058