


# Harry L. Greene, Surveyor

2160 Tremont Center, Columbus, Ohio 43221

PLAT SHOWING SURVEY OF LOTS NOS. 41 AND 42, LINCOLN HEIGHTS SUBDIVISION  
CITY OF COLUMBUS, OHIO, AS SHOWN OF RECORD IN PLAT BOOK 7, PAGE 250,  
RECORDER'S OFFICE, FRANKLIN COUNTY, OHIO.

PB. 7 Page 250 Recorders Office, Franklin County, Ohio.  
Scale 1" = 20' Date February 23, 1989

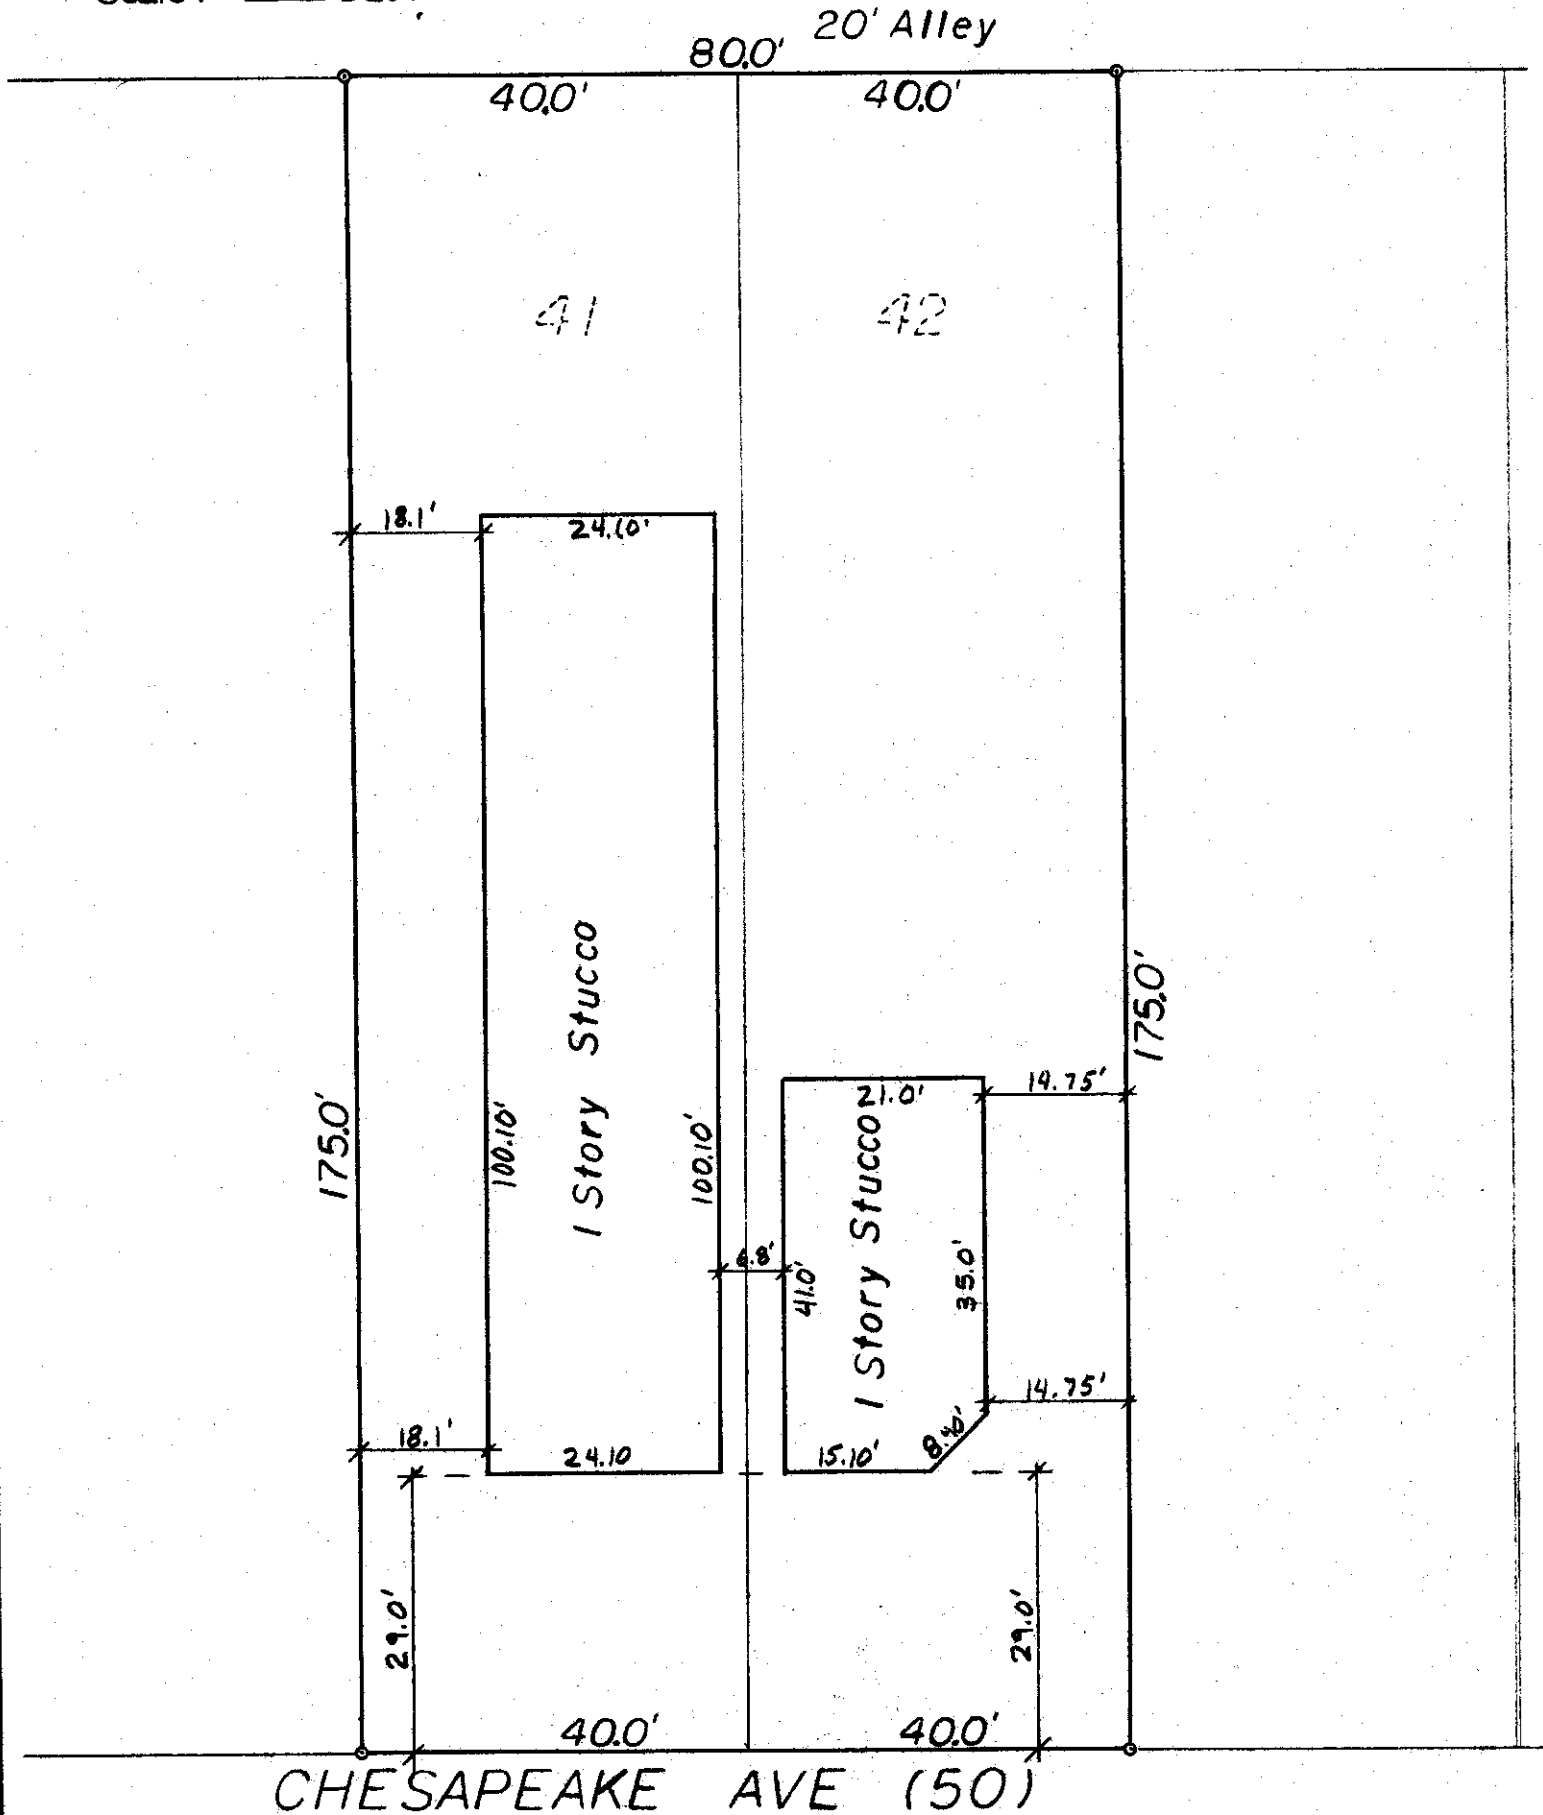

I hereby certify the above plat has been prepared from actual survey of the premises for use in mortgage loan and title purposes only. No sideline of principal building is less than dimension shown. Property corners not located unless shown thus -o-.

*Harry L. Greene*  
Harry L. Greene, Registered Surveyor, No. 4058