

# Harry L. Greene, Surveyor


2160 Tremont Center, Columbus, Ohio 43221

Plat showing Boundary Survey and Driveway Encroachment

For: Peggy Rollins

Mariam Subdivision No.2 Block No.8 Lot No.19

PB. 26 Page 42 Recorders Office, Franklin County, Ohio.  
Scale 1" = 20' Date June 5, 1990

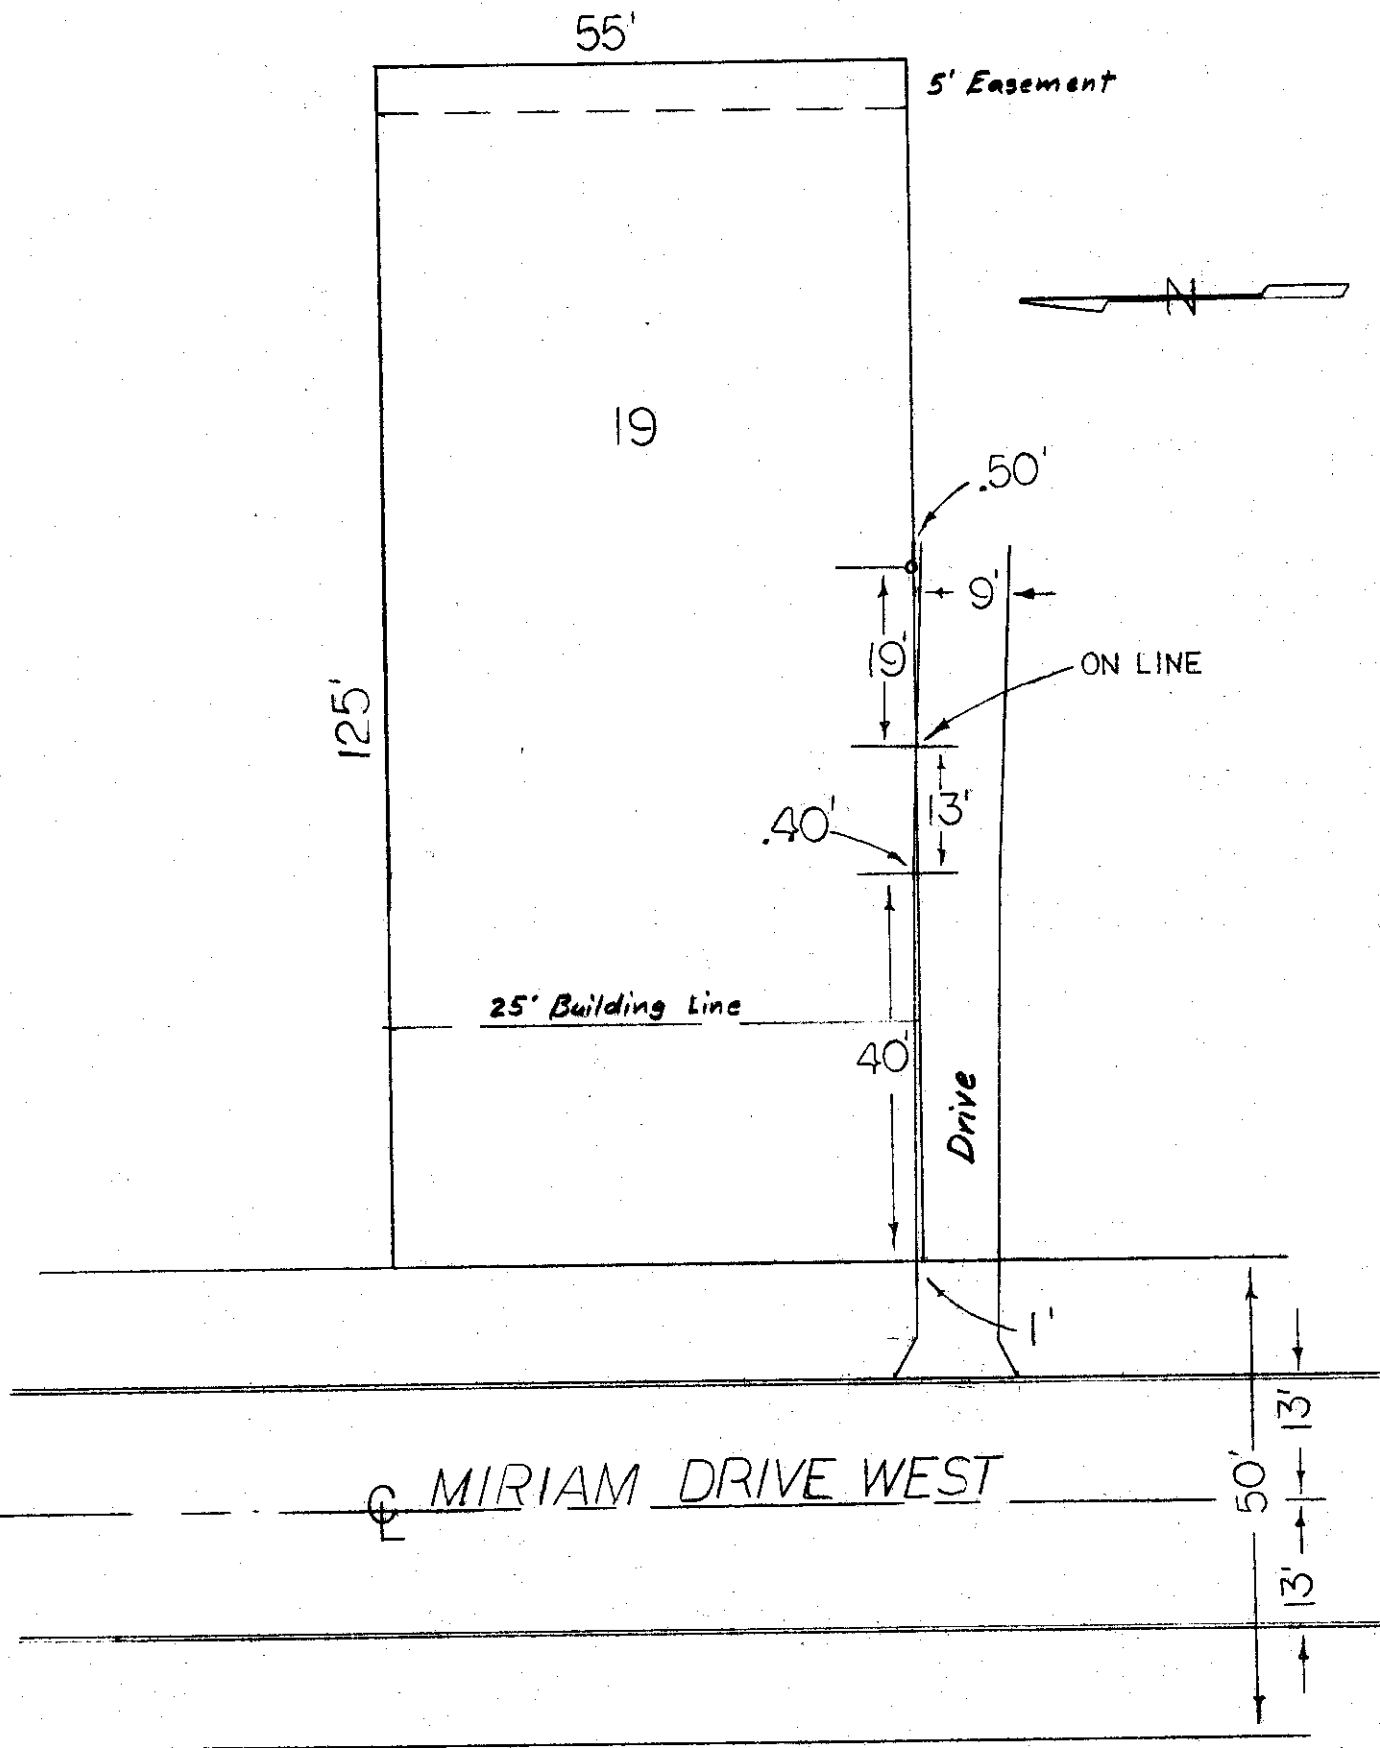

I hereby certify the above plat has been prepared from actual survey of the premises

*Harry L. Greene*  
Harry L. Greene, Registered Surveyor, No. 4058