


Harry L. Greene, Surveyor

2160 Tremont Center, Columbus, Ohio 43221

PLAT SHOWING PARTIAL SURVEY OF Lot No. 31, Shelbourne Heights No. 4, City of Upper Arlington, Ohio.

PB. _____ Page _____ Records Office, Franklin County, Ohio.
Scale 1" = 30' Date March 22, 1990

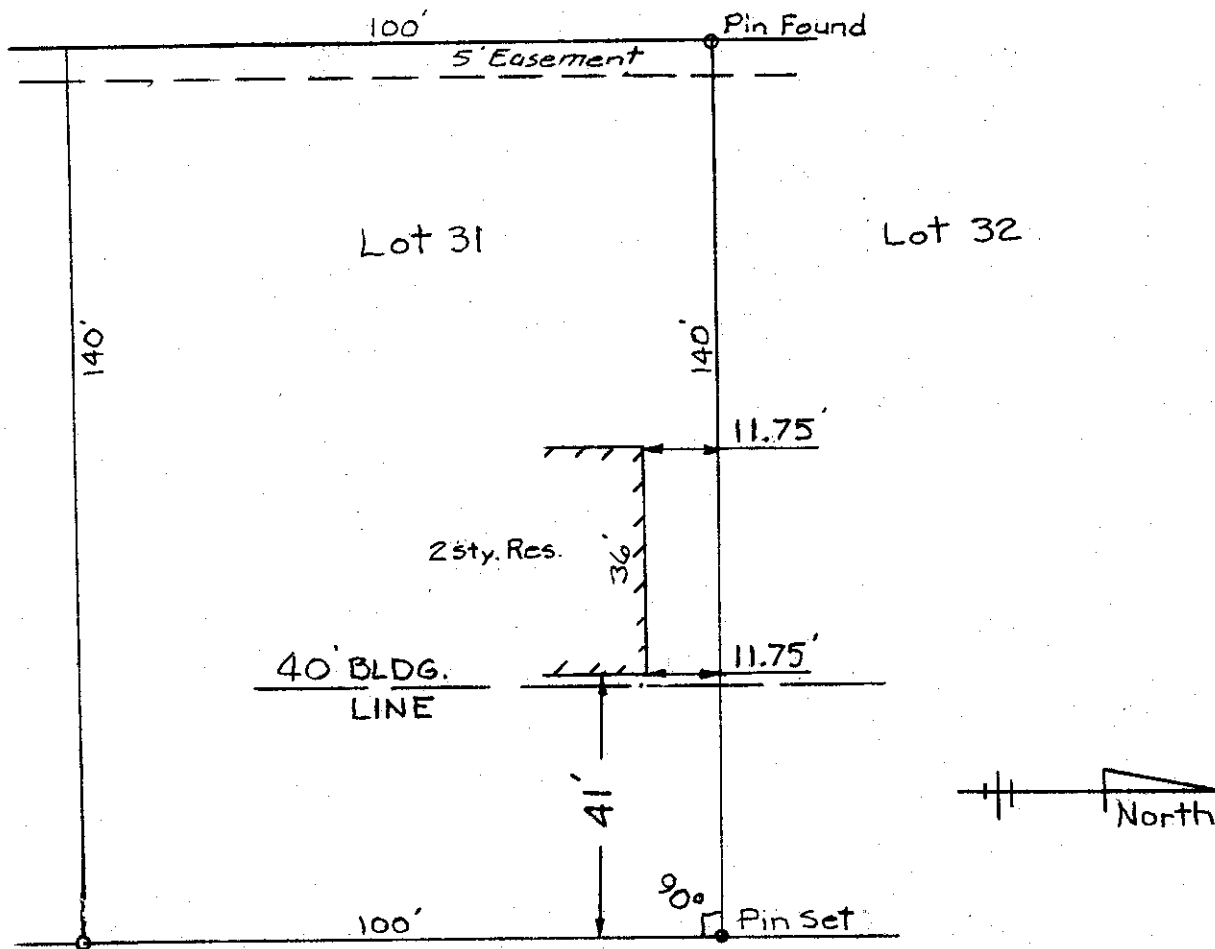

TETFORD ROAD

I hereby certify the above plat has been prepared from actual survey of the premises

Harry L. Greene
Harry L. Greene, Registered Surveyor, No. 4058