

# CURRY HAWK WILLIS & GROVE, Inc.


ENGINEERS AND SURVEYORS

2160 TREMONT CENTER, COLUMBUS, OHIO 43221

For: Northwest Title  
and/or  
Huntington Mortgage Company  
Re: Tolbert  
Lot No. 64, Northcrest, City of Columbus, Ohio

VOLUME 38, PAGE 87 RECORDERS OFFICE, Franklin COUNTY, OHIO  
SCALE 1" = 20 DATE Sept 17, 1991

FLOOD ZONE "C" AS PER F.I.R.M. 390170 0035B

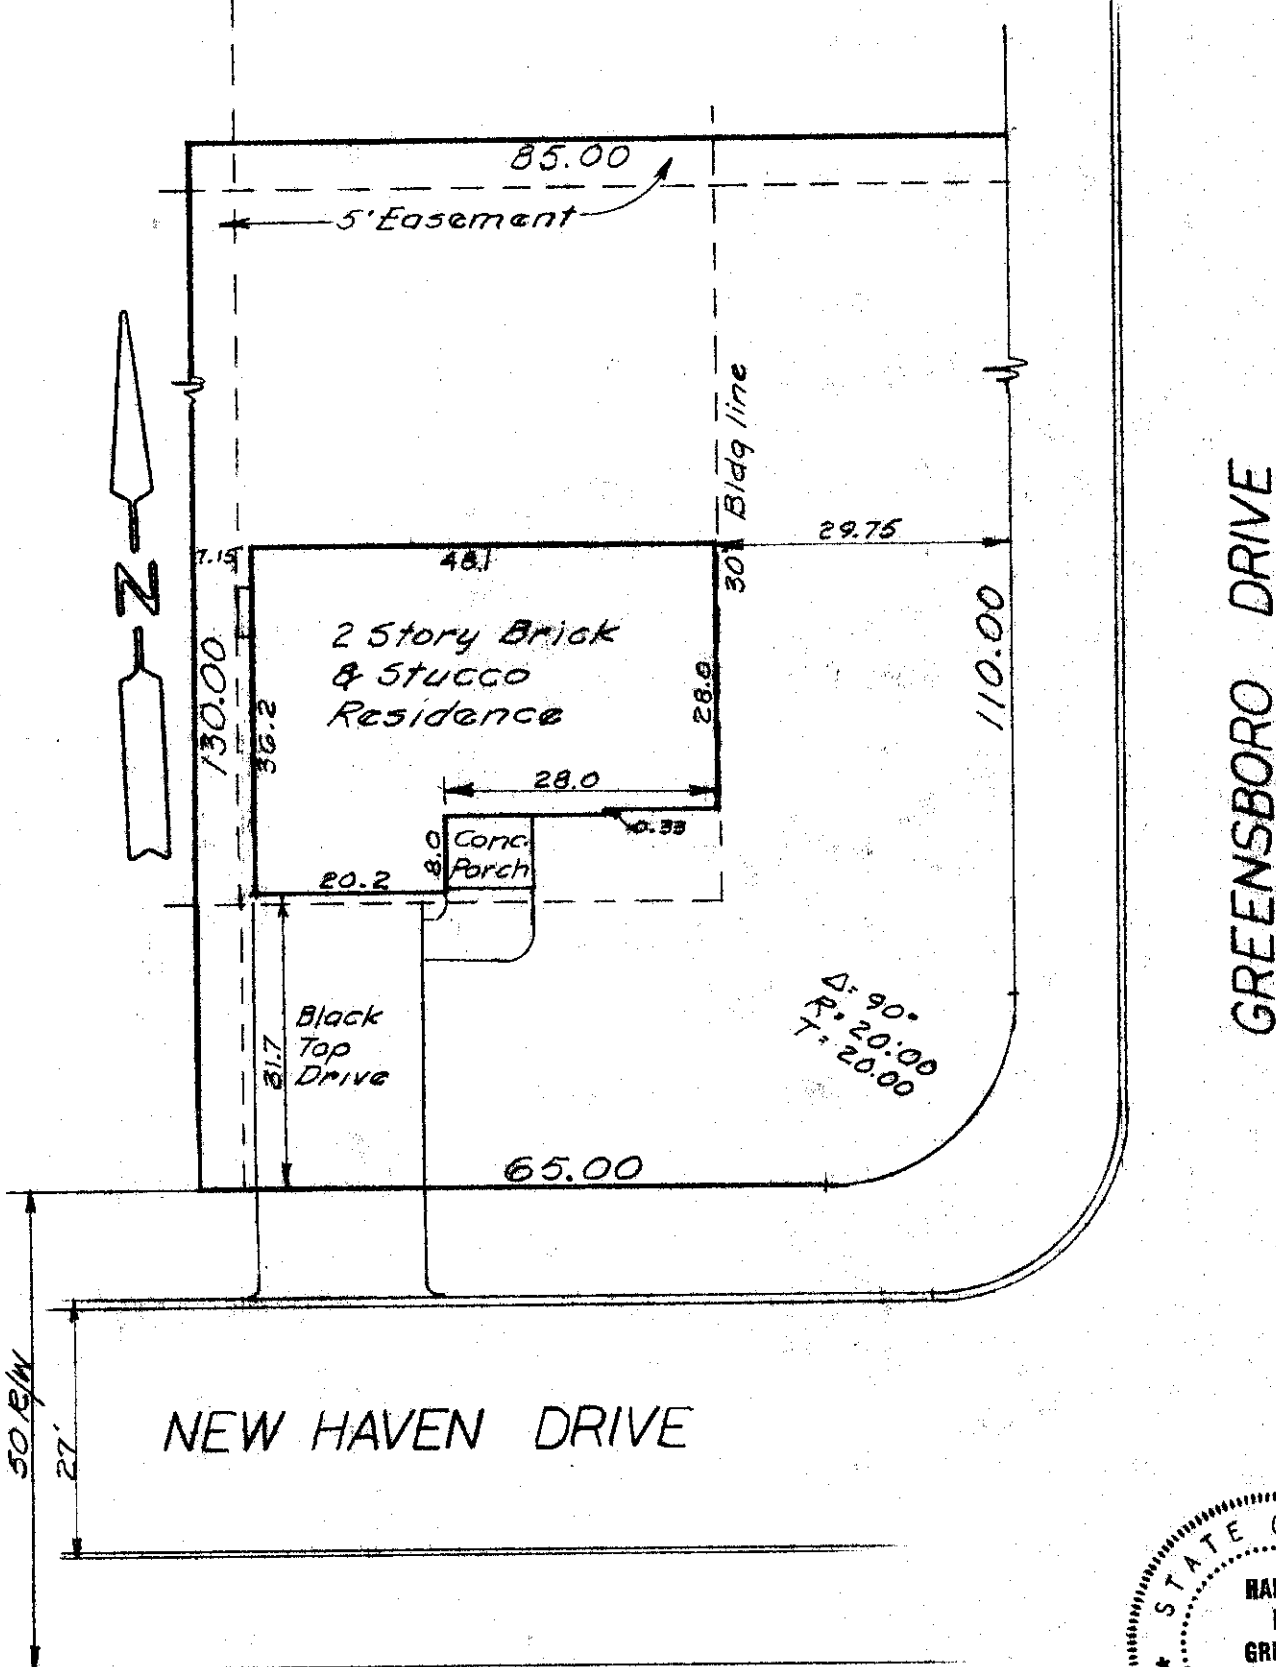

THIS SURVEY IS A MORTGAGE LOCATION  
PREPARED IN ACCORDANCE WITH CHAPTER  
4733-38 OF THE OHIO ADMINISTRATIVE CODE,  
AND IS NOT A BOUNDARY SURVEY PURSUANT  
TO CHAPTER 4733-37 OF SAID CODE.

*Harry L. Greene*  
Harry L. Greene

REGISTERED SURVEYOR NO. 4058

