



CURRY HAWK WILLIS & GROVE, Inc.

ENGINEERS AND SURVEYORS


2160 TREMONT CENTER, COLUMBUS, OHIO 43221

PLAT OF SURVEY
 LOT 22 BRANDON HEIGHTS ADDITION
 P.B.19 PG.30
 Franklin Co., Upper Arlington, Oh.

SCALE 1" = _____ DATE 12-11-91

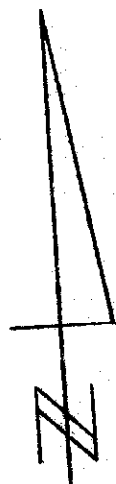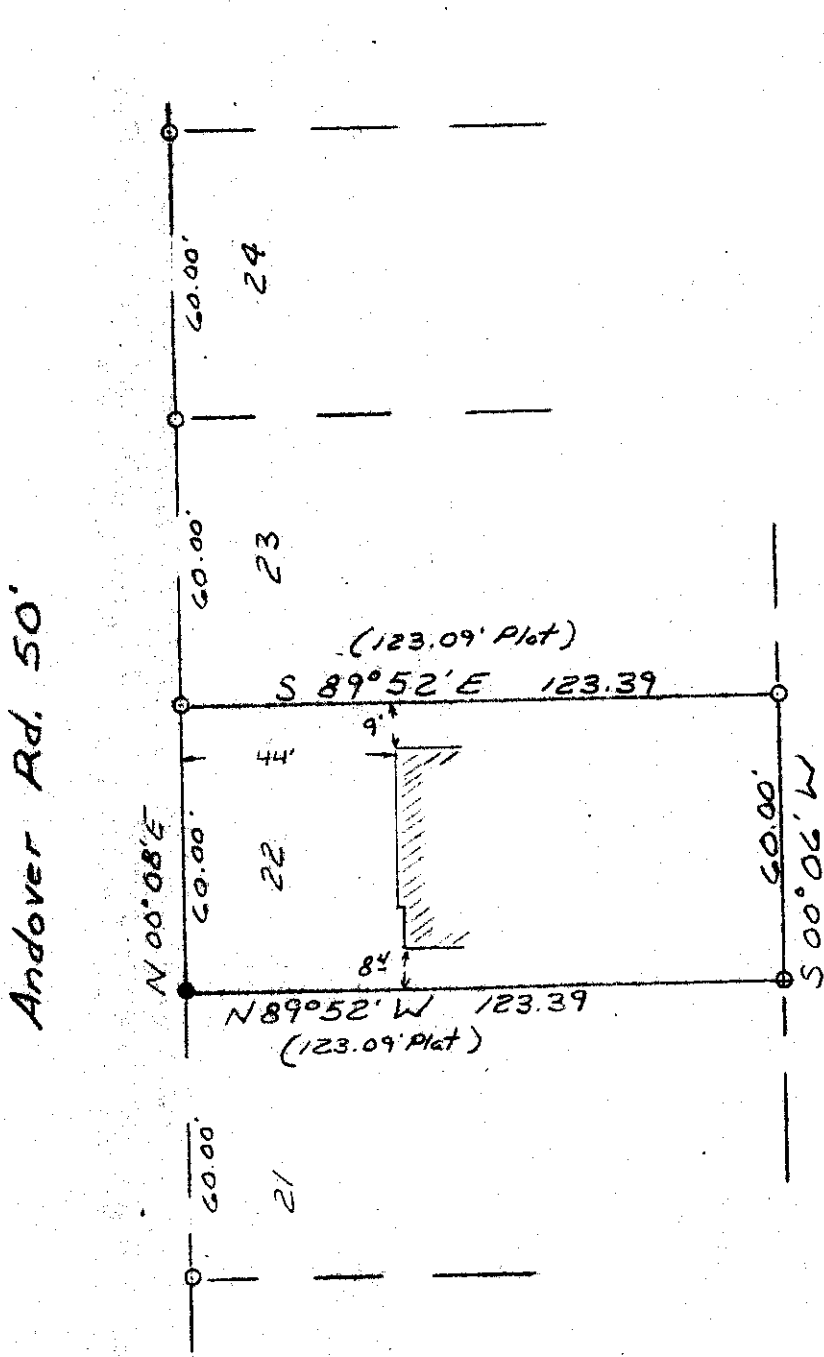

All iron pins set are 5/8" x30" rebar with an identification cap. The bearings are based on the Plat of Brandon Heights Add. .

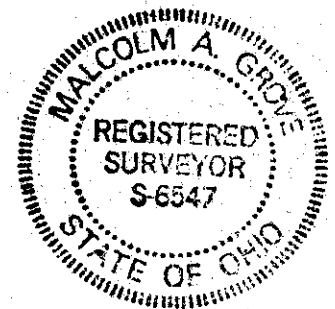

CURRY HAWK WILLIS & GROVE, INC. ENGINEERS AND SURVEYORS 2160 TREMONT CENTER • COLUMBUS, OHIO 43221		
TITLE: ELOISE BAKER		
SCALE: 1"=40'	DRN. BY: MG	JOB NO. 113-11-91
DATE: 12-11-91	CHK. BY:	

Malcolm A. Grove
 REGISTERED SURVEYOR NO. S6547