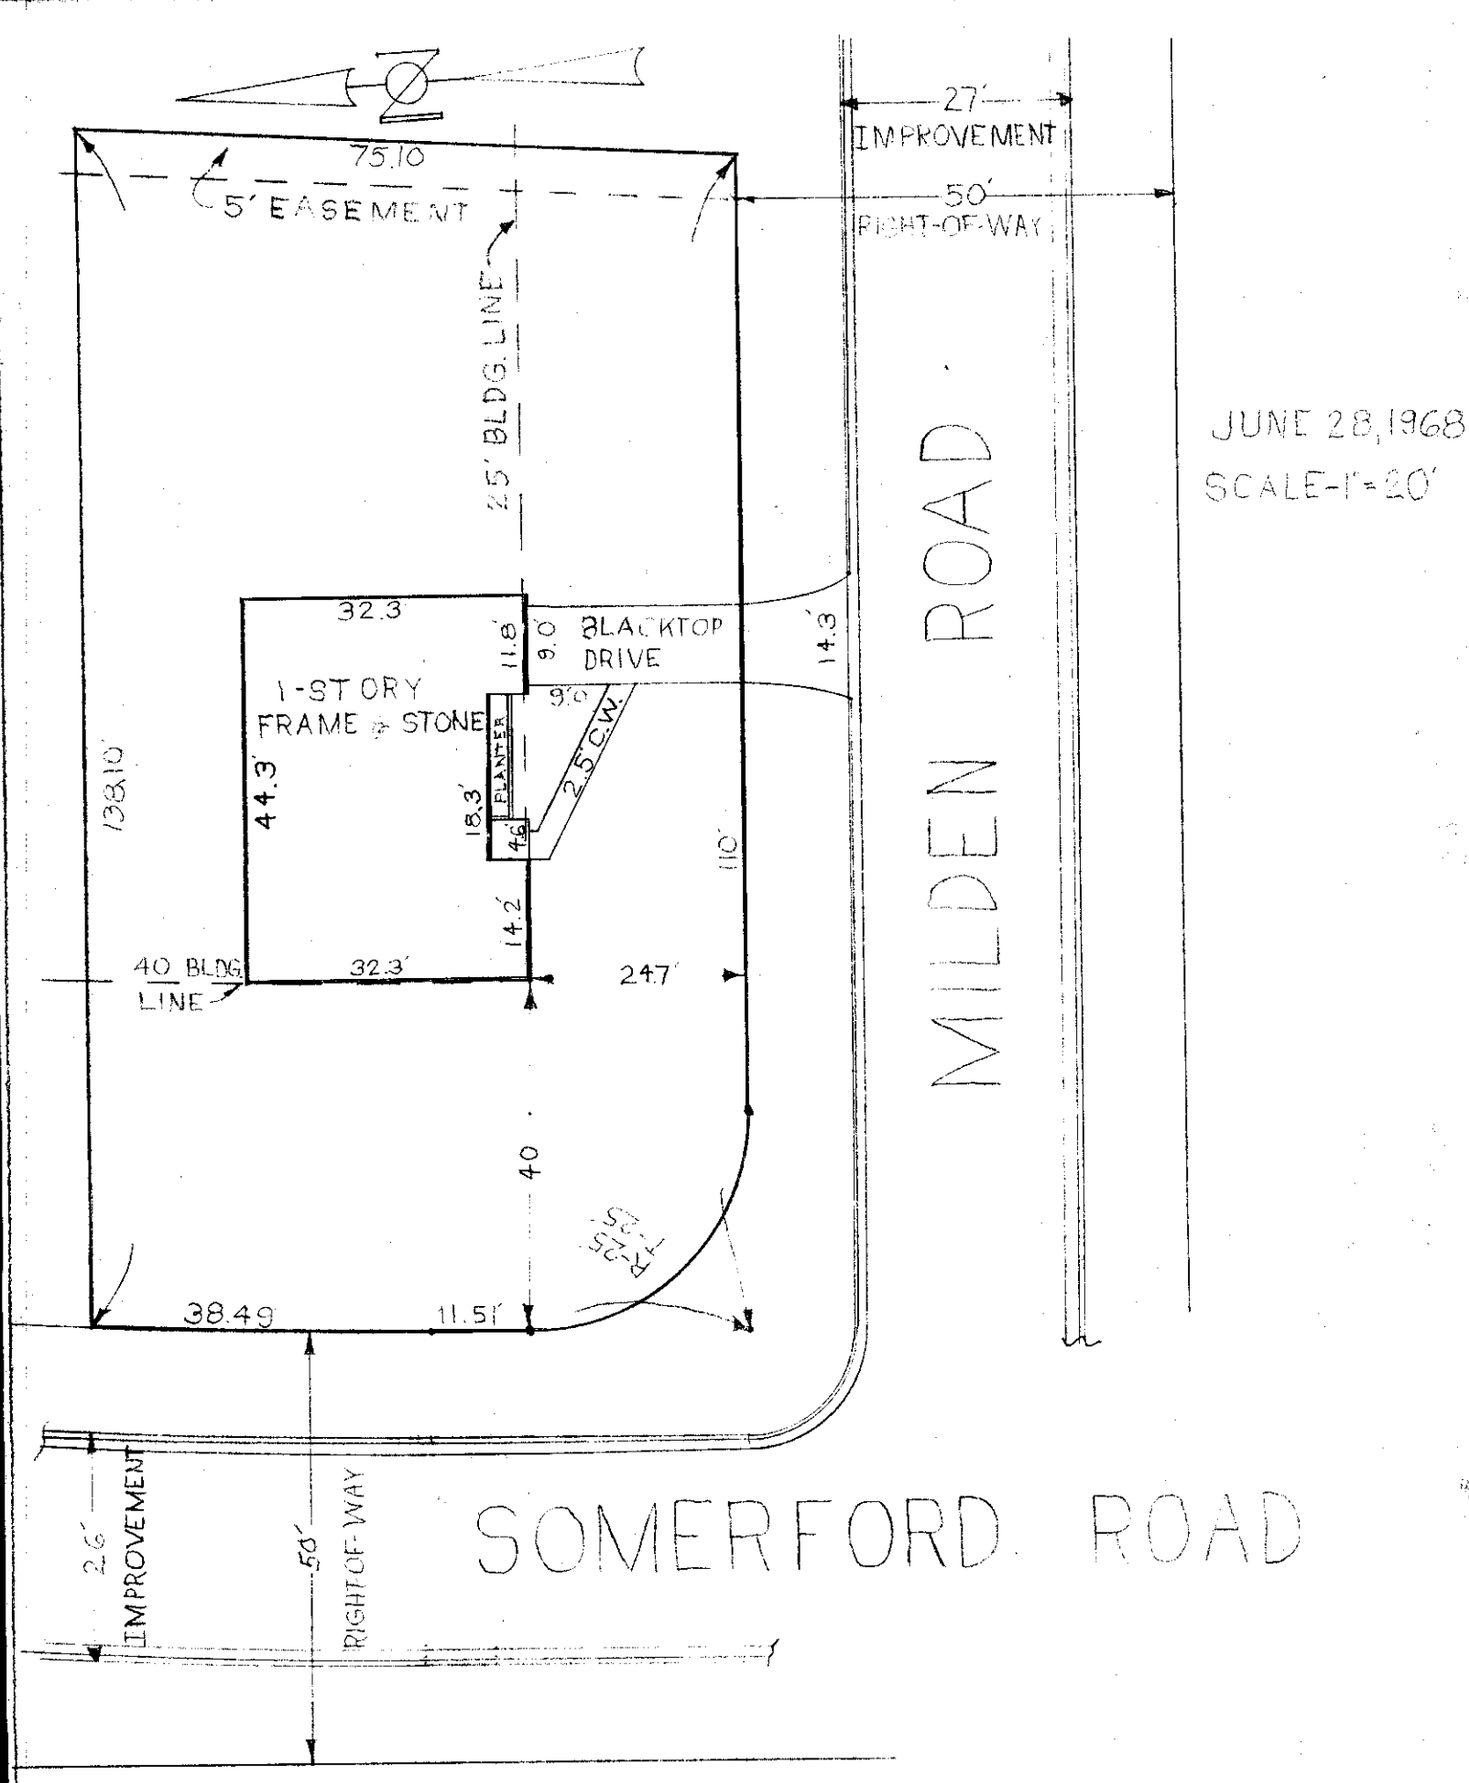

1880 Milden Road
City of Upper Arlington, Franklin County, Ohio.
Galbreath Mortgage Company,
Re: Willard Landis

BLUE PRINT SURVEY

I hereby certify that I have prepared the above plat from survey and inspection of herein described premises and existing conditions are as shown above.
Being Lot No. 19, Block No. 278, NORTH MOUNTVIEW ADDITION, of record in Plat Book 21, page 50, Recorder's Office, Franklin County, Ohio.

Harry L. Greene

Harry L. Greene, Reg. Surveyor, No. 4058

28-06-68