

SHREWSBURY

ROAD 50'

E

curb ↘

SUNSET DR.

60'

42'

Drive

35' Bldg. Line

7.3'

cs Planter

23.4'

20.9'

1-floor frame brick & stucco

44.3'

10.5'

conc. patio.


32.9'

125' Blacktop

wire fence

5' Easement

60'

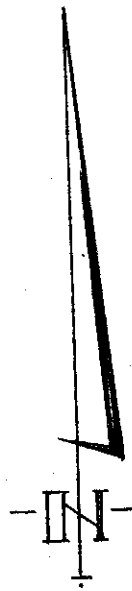

July 1 - 1968
Scale 1" = 20'

2721 SHREWSBURY RD.

City of Upper Arlington, Franklin County, Ohio.
Breath Mortgage Company.

Robert Mossor

~ Blue Print Survey ~

I hereby certify that I have prepared the above
plot from survey and inspection of herein
described premises and existing conditions are as
shown above. Being Lot 8 of Block 8, of RIVER
EDGE ADDITION of record in Plat Book 19,
pp. 2-3-4, Recorder's Office, Franklin County, Ohio

Harry L. Greene
Harry L. Greene, Reg. Surveyor - No. 4058

01-07-68