


16' Alley (Unimproved)

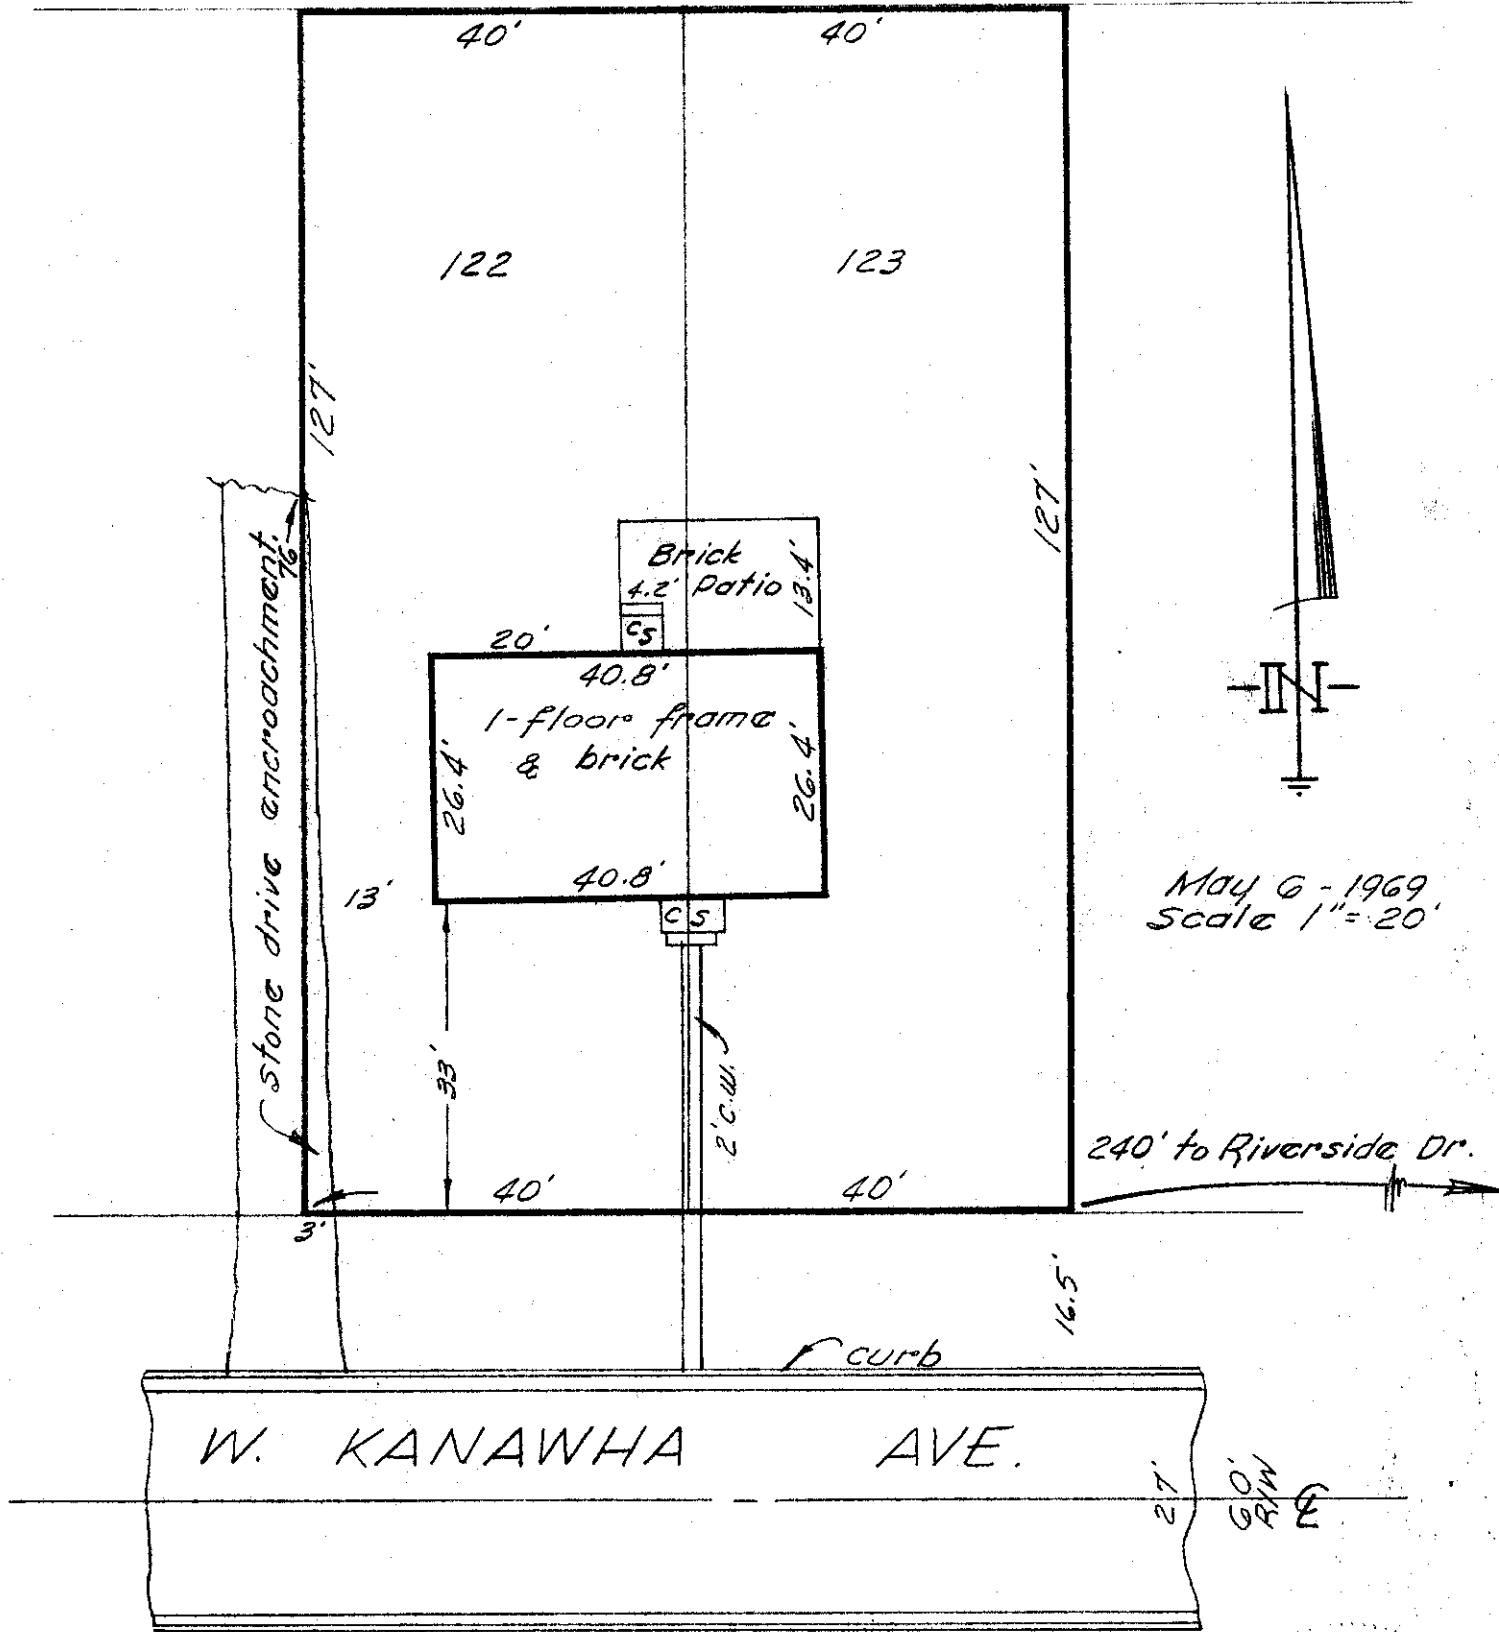

430 W. KANAWHA AVE.

Sharon Township, Franklin County, Ohio.

Galbreath Mortgage Company.

Re: Donald F. Burris.

~ Blue Print Survey ~

I hereby certify that I have prepared the above plat from survey and inspection of herein described premises and existing conditions are as shown above. Being Lot 122 & 123 of TREMONT GARDENS, of record in Plat Book 10, pgs. 238-9, Recorder's Office, Franklin County, Ohio.

Harry L. Greene

Harry L. Greene, Reg. Surveyor - No. 4058.