


ONANDAGA

DRIVE 60'

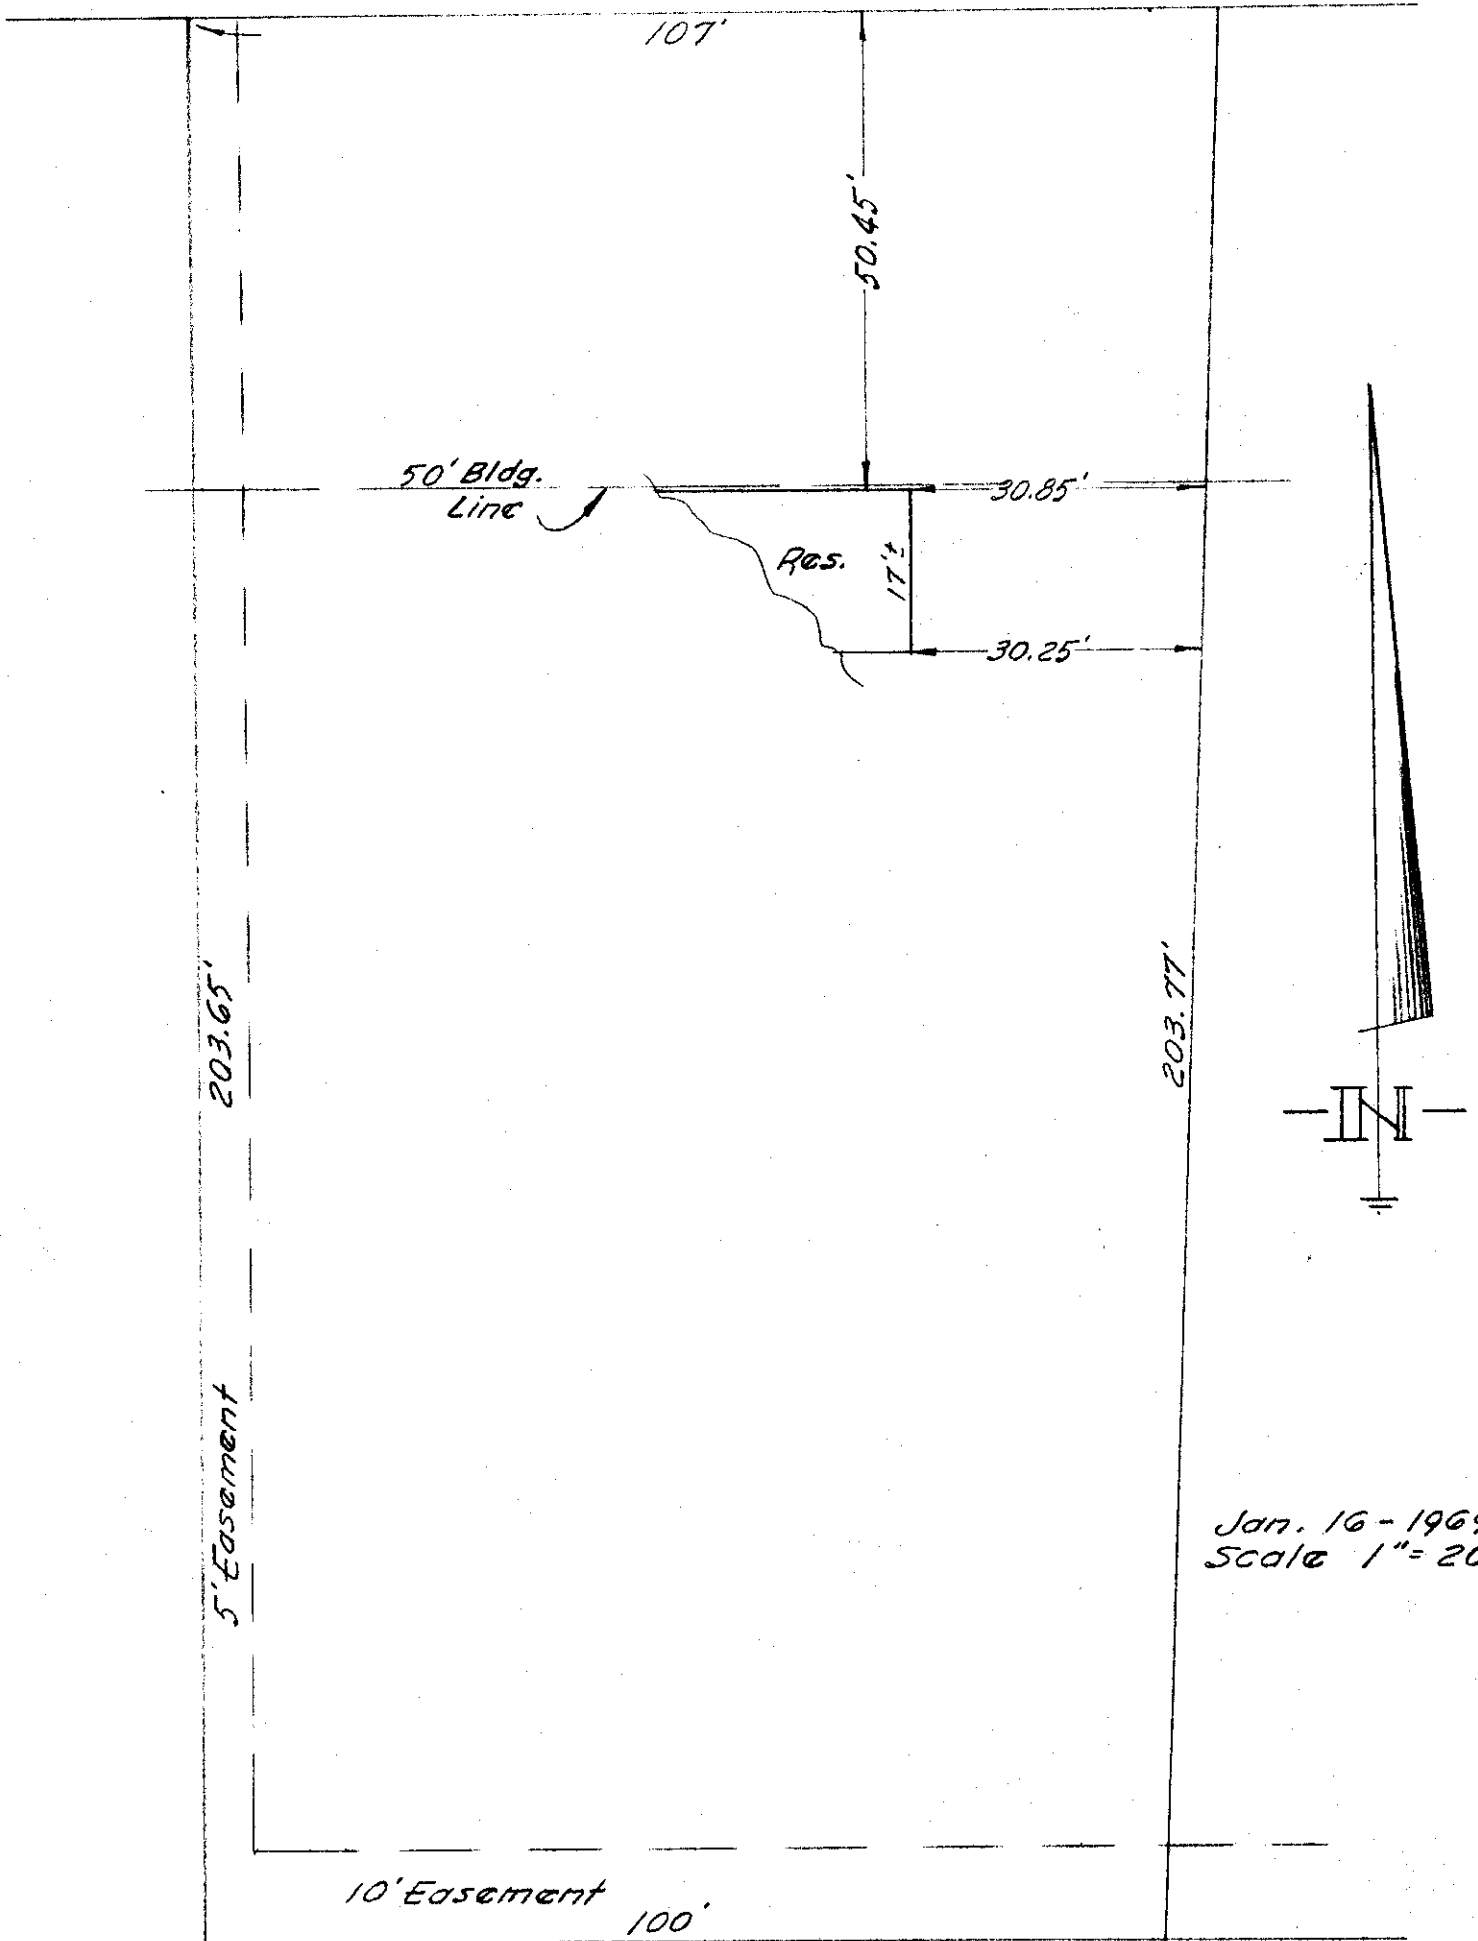

2239 ONANDAGA DRIVE, City of Upper
 Arlington, Franklin County, Ohio.
 Lot No. 24, Block 201, of the PLAT OF BLOCKS No 201
 & THE SOUTH PART OF BLOCKS Nos 202 AND 203
 VILLAGE OF UPPER ARLINGTON - Plat Book 20, Page 26.

Harry L. Greene
 Harry L. Greene, Reg. Surveyor - No. 4058