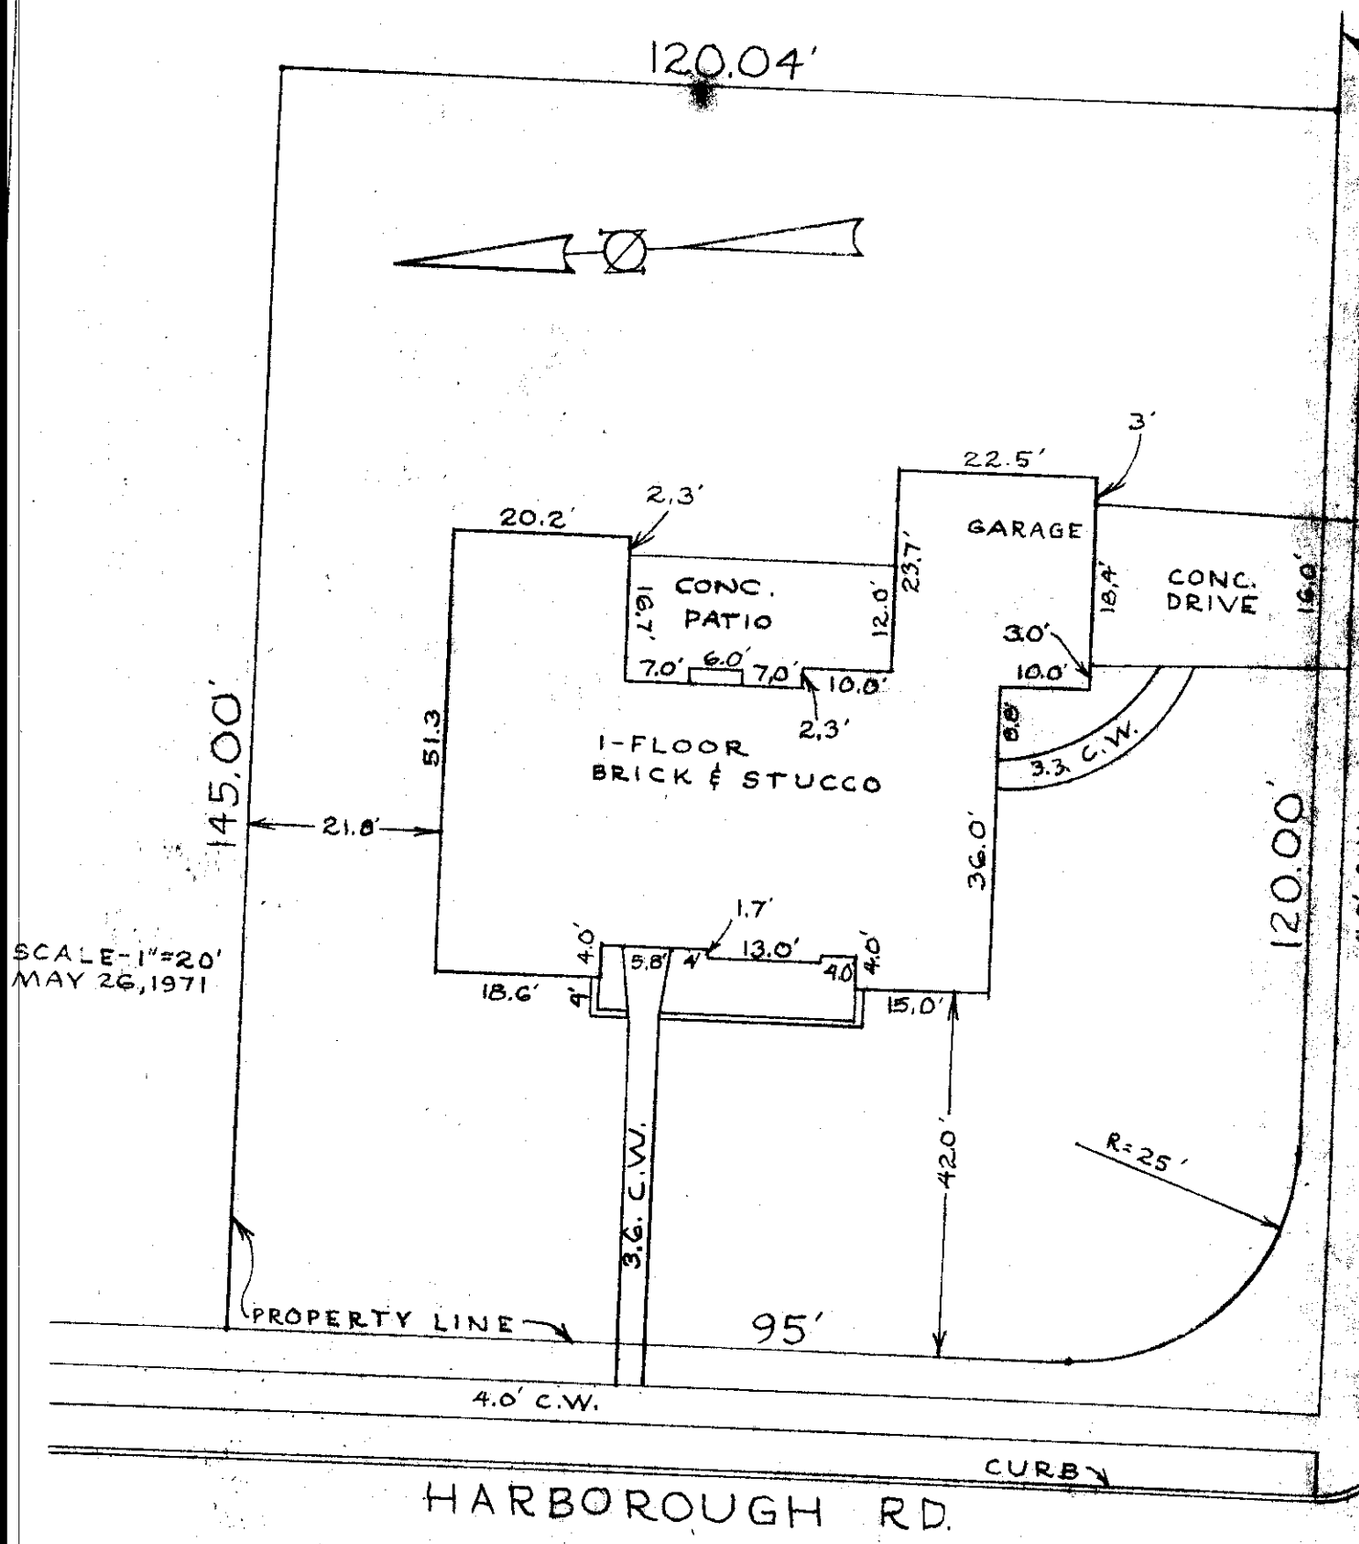

4290 Harborough Road

City of Upper Arlington, Franklin County, Ohio.
Re. Philip S. Campbell.
Blue Print Survey

I hereby certify that I have prepared the above plat from survey and inspection of herein described premises and existing conditions are as shown above.

Being lot No. 1, Block No. 325, Shelbourne Heights, Plat Book 29, pg.41, Recorder's Office, Franklin County, Ohio.

Harry L. Greene

Harry L. Greene Reg. Surveyor No. 4058.