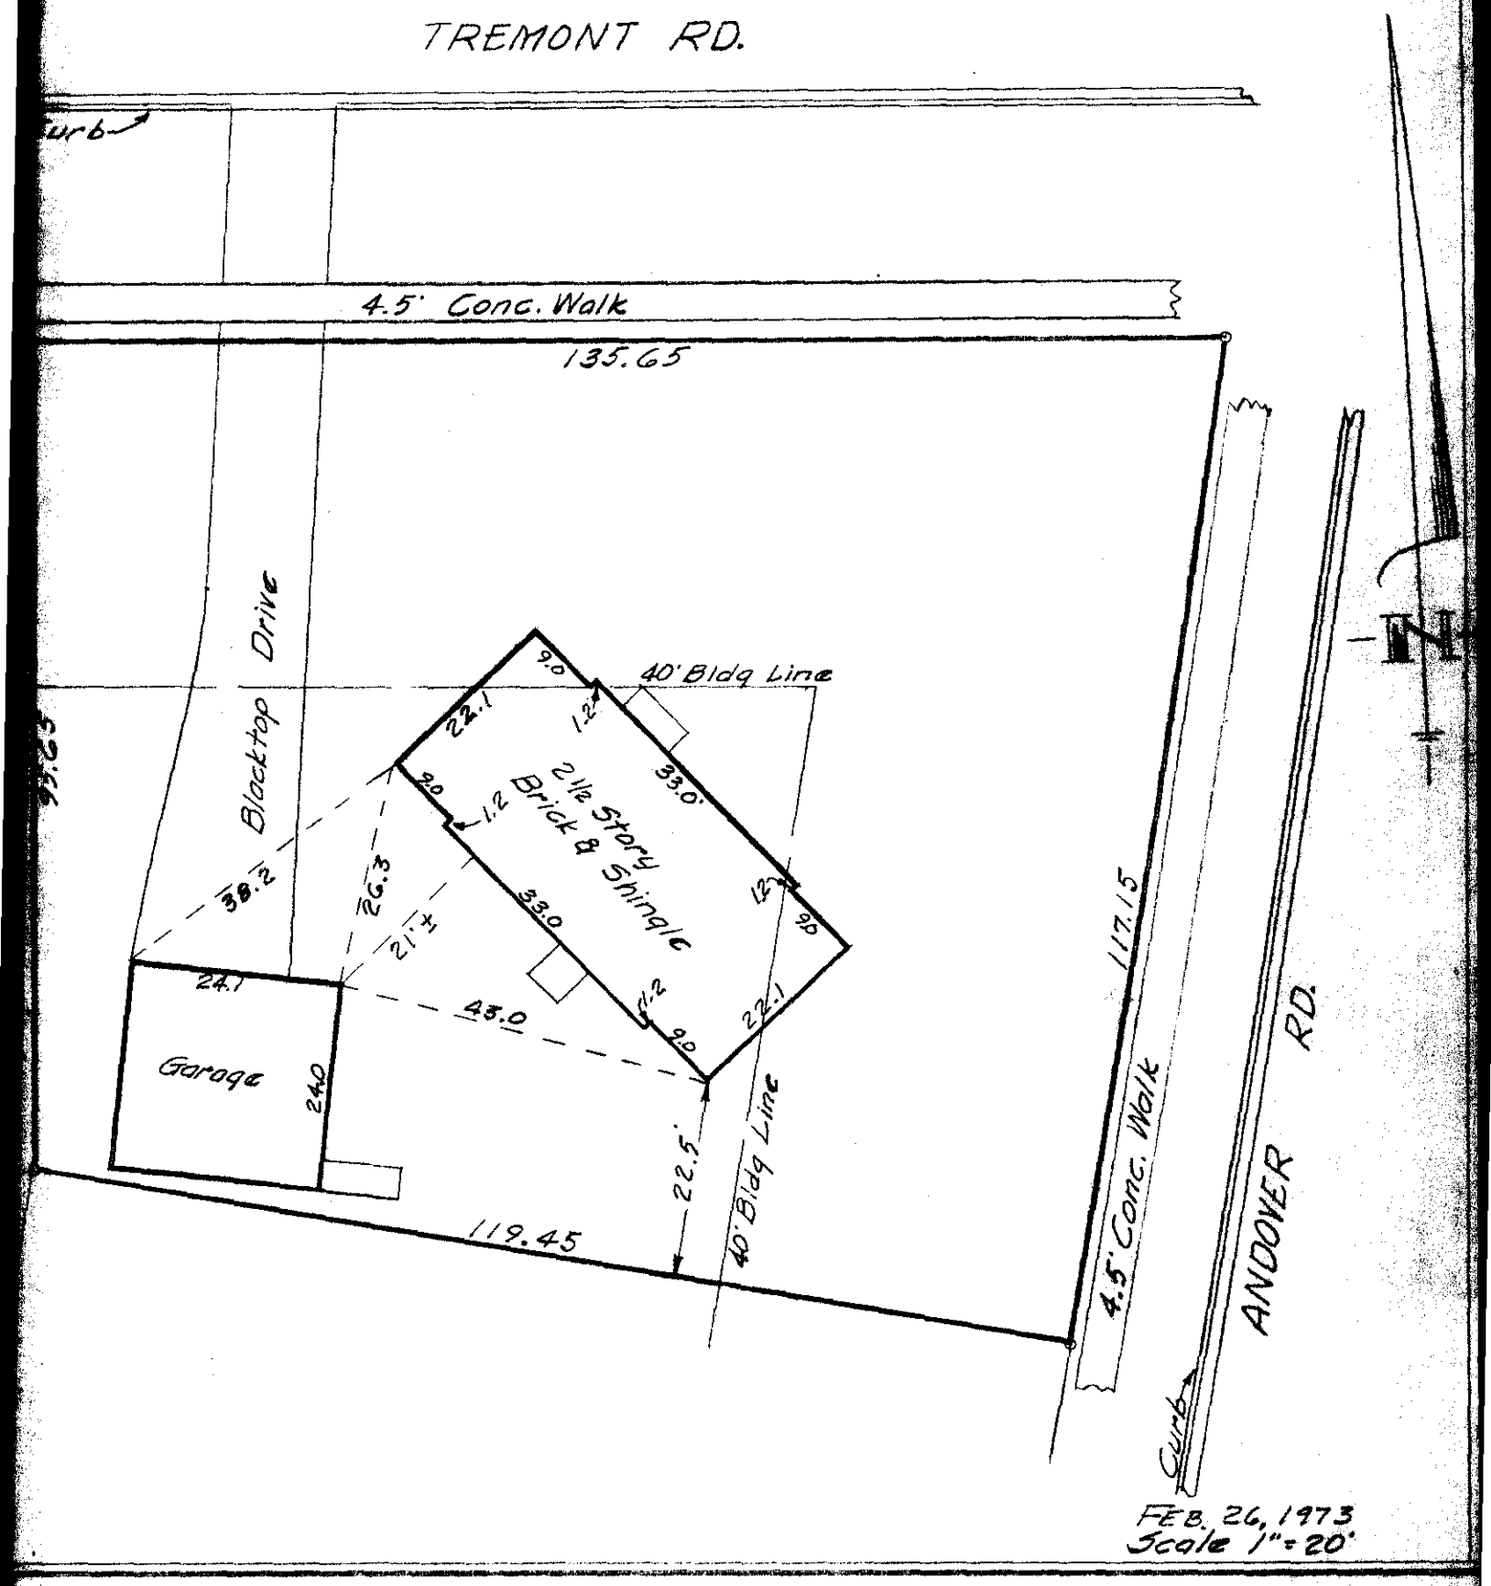

1811 TREMONT ROAD.

CITY OF UPPER ARLINGTON, FRANKLIN COUNTY, OHIO

RE: JOSEPH J. HARPER

I HEREBY CERTIFY THAT I HAVE PREPARED THE ABOVE PLAT FROM SURVEY AND INSPECTION OF HEREIN DESCRIBED PREMISES AND EXISTING CONDITIONS ARE AS SHOWN ABOVE.

BEING LOT NO 12, BLOCK 22, OF THE PLAT OF BLOCKS 1 TO 23, UPPER ARLINGTON, OF RECORD IN PLAT BOOK 12, PAGES 23 AND 24, RECORDER'S OFFICE, FRANKLIN COUNTY, OHIO.

Harry L. Greene

Harry L. Greene, Reg. Surveyor, No. 4058