


SCHREYER PLACE



N. HIGH ST.

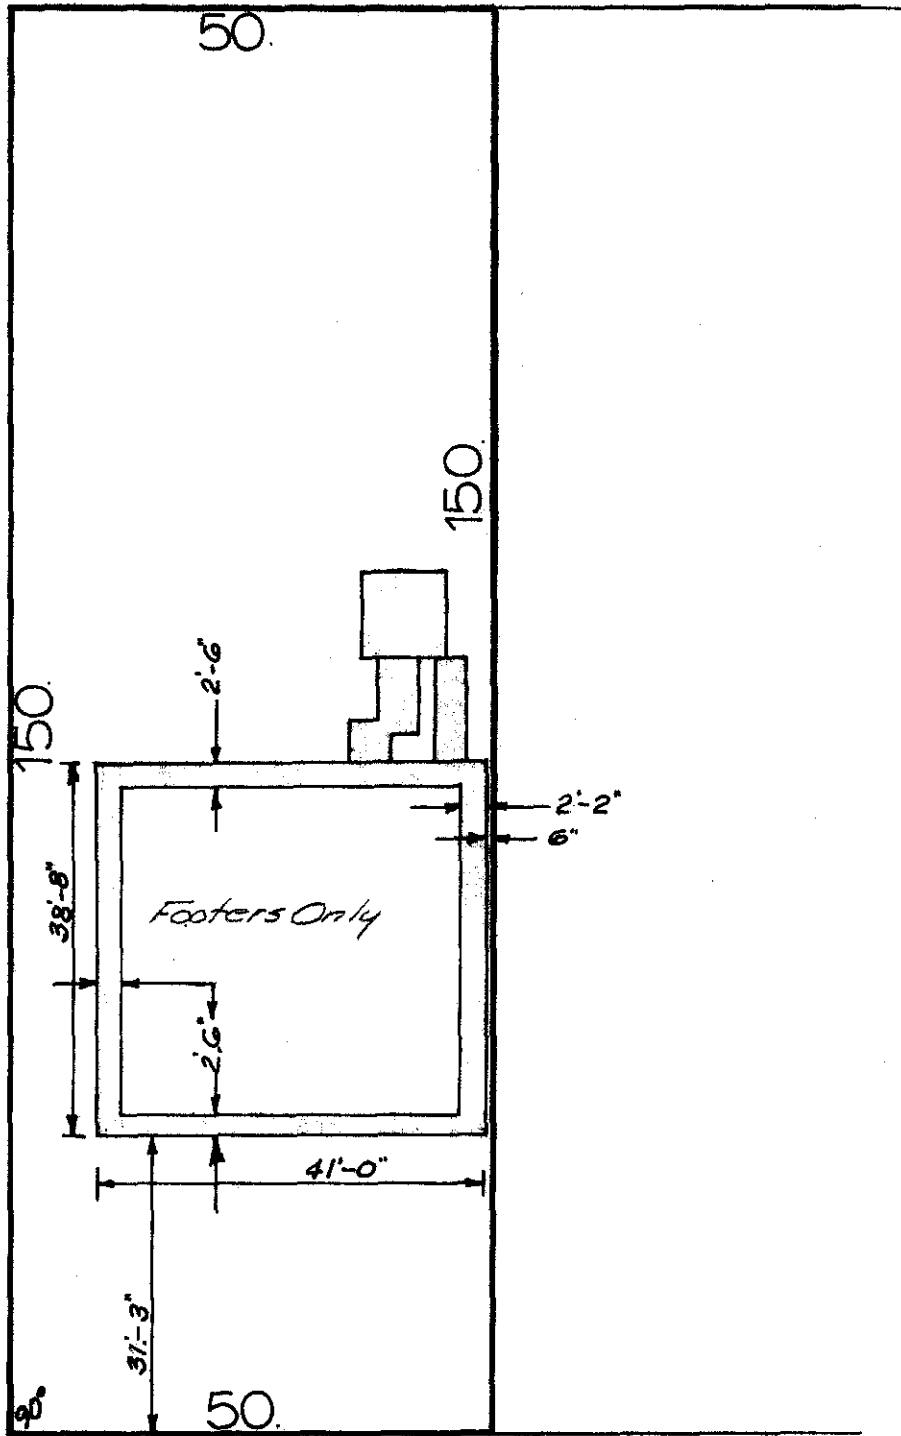

Scale 1"=20' Sept. 19, 1974

4425 North High Street,  
City of Columbus, Franklin County, Ohio.  
Re: High-Schreyer Co.,

BLUE PRINT SURVEY

I hereby certify that I have prepared the above plat from survey and inspection of herein described premises and existing conditions are as shown above. Being Lot No. 6, ROSEMARY ADDITION, of record in Plat Book 15, page 23, Recorder's Office, Franklin County, Ohio.

*Harry L. Greene*  
Harry L. Greene, Reg. Surveyor, No. 4058