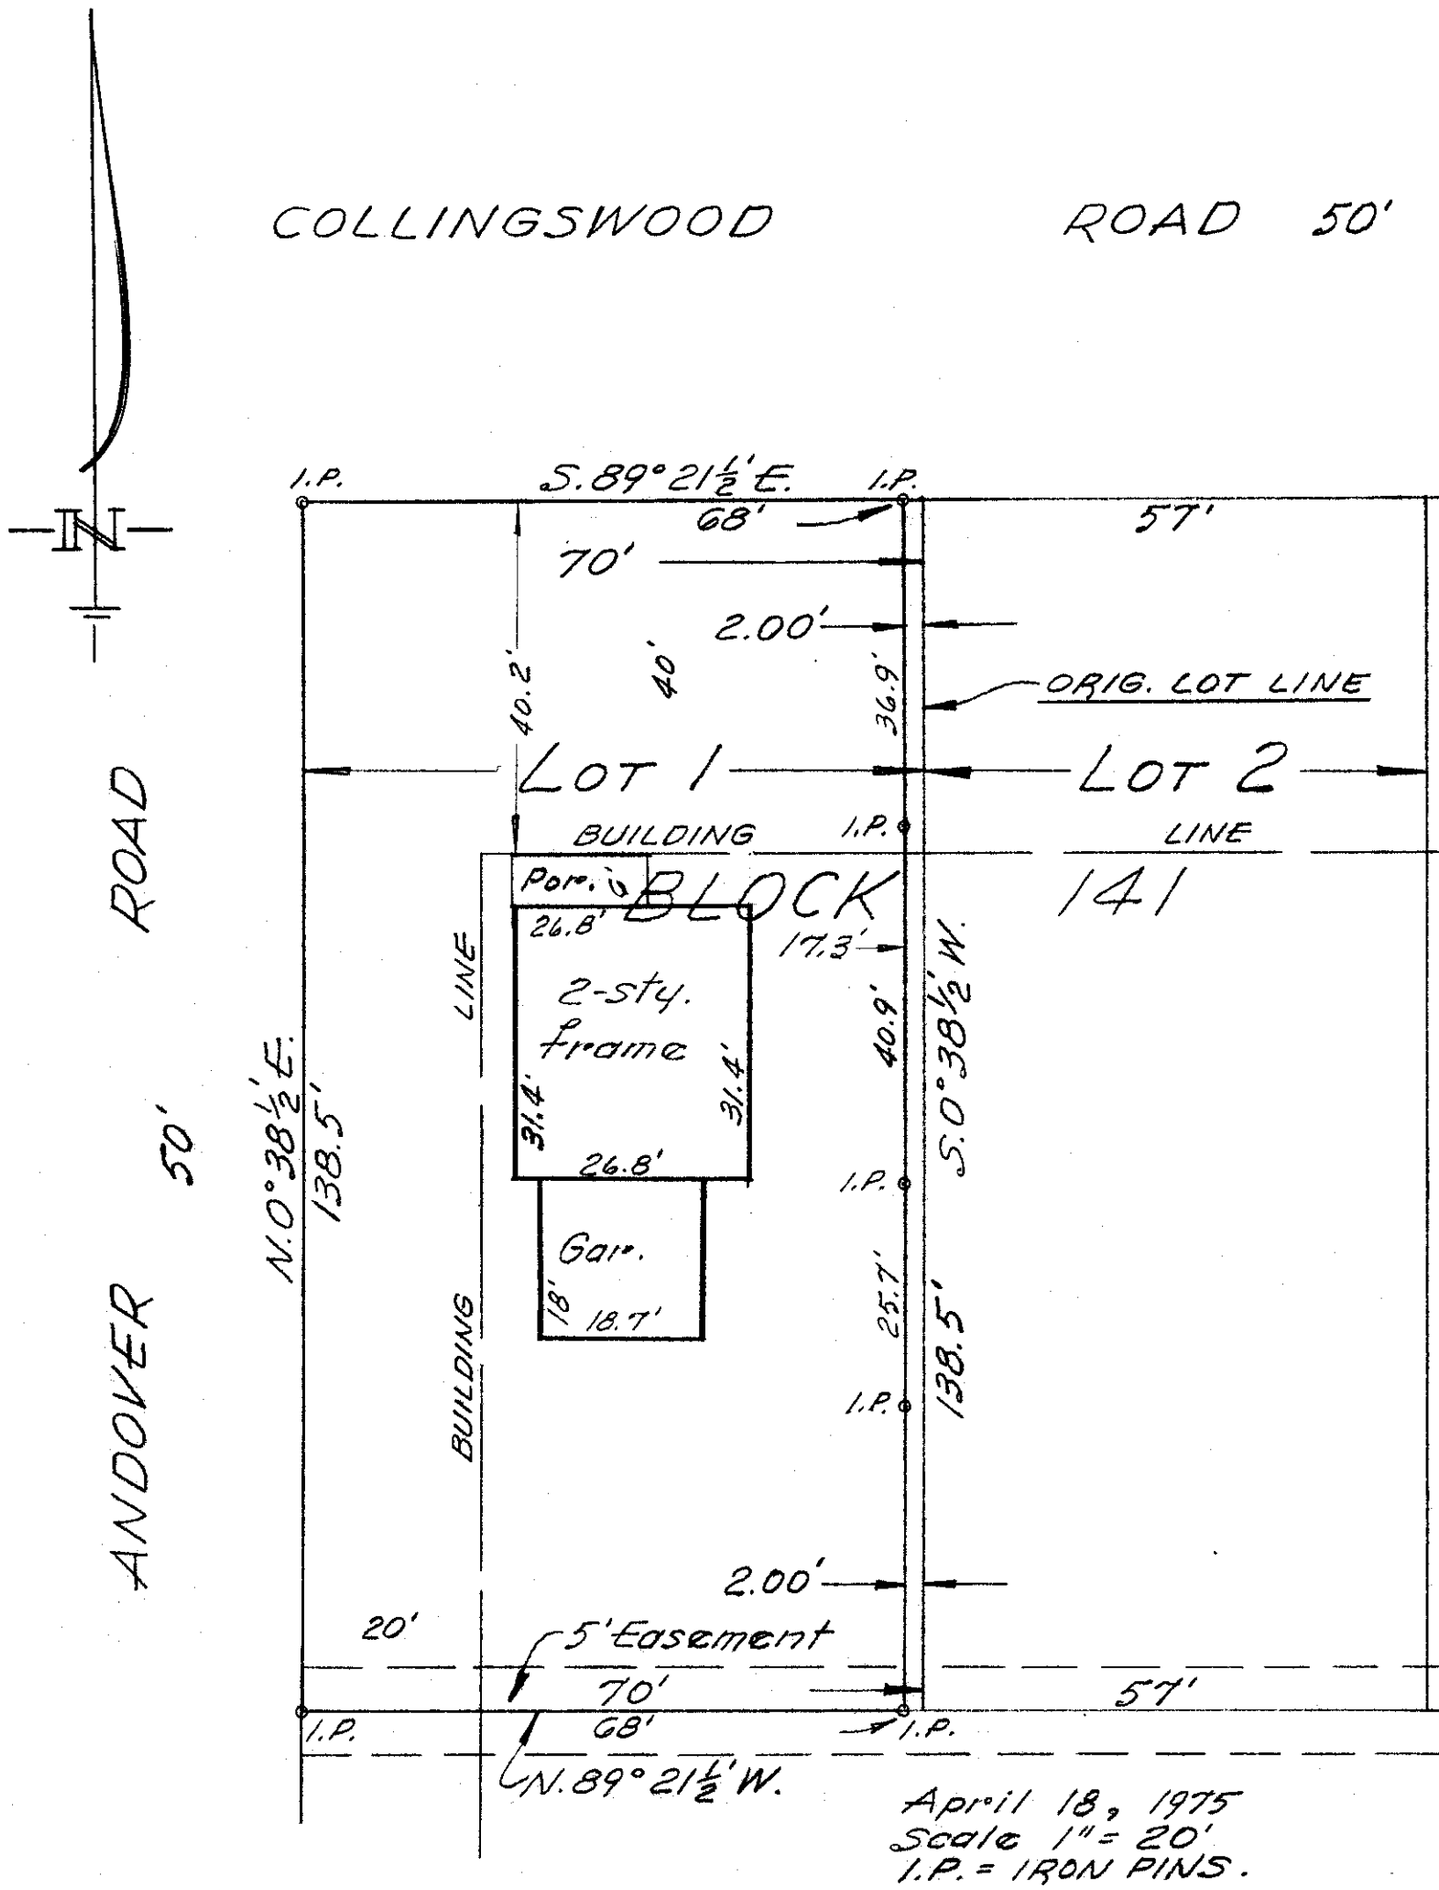

— Description —

Situated in the City of Upper Arlington, Franklin County, Ohio, and being 2.00 ft. off the entire Easterly Side of Lot 1, Block 141, of THE UPPER ARLINGTON CO'S. PLAT OF BLOCKS 60 & 126 TO 150 VILLAGE OF UPPER ARLINGTON (EXCEPTING BLOCKS 140 & 143) of record in Plat Book 18, pg. 34-35, Recorder's Office, Franklin County, Ohio.

Harry L. Greene

Harry L. Greene, Reg. Surveyor - 4058.