


STANFORD (50) ROAD

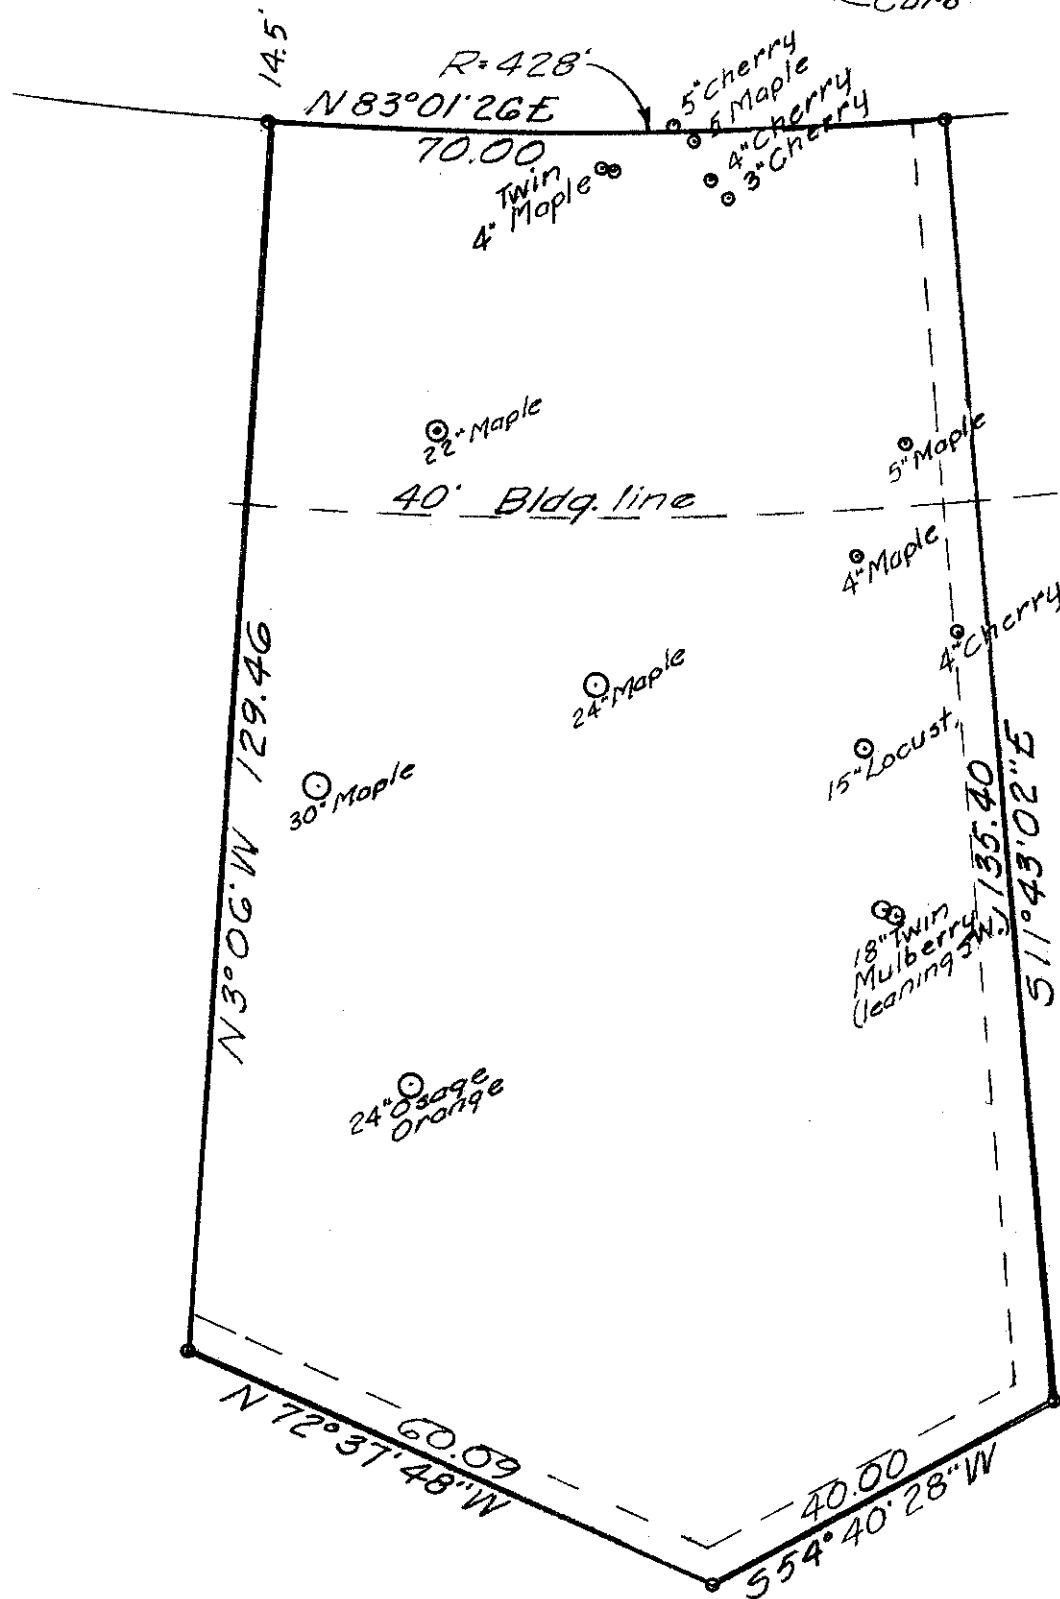

Scale 1"=20'
Nov. 18, 1977

PLAT SHOWING SURVEY OF LOT NO. 9, Block No. 11, UPPER ARLINGTON, OHIO,
PLAT BOOK 12, PAGE 23, RECORDER'S OFFICE, FRANKLIN COUNTY, OHIO.

Joseph. Greene
 Harry I. Greene, Reg. Surveyor, No. 4058