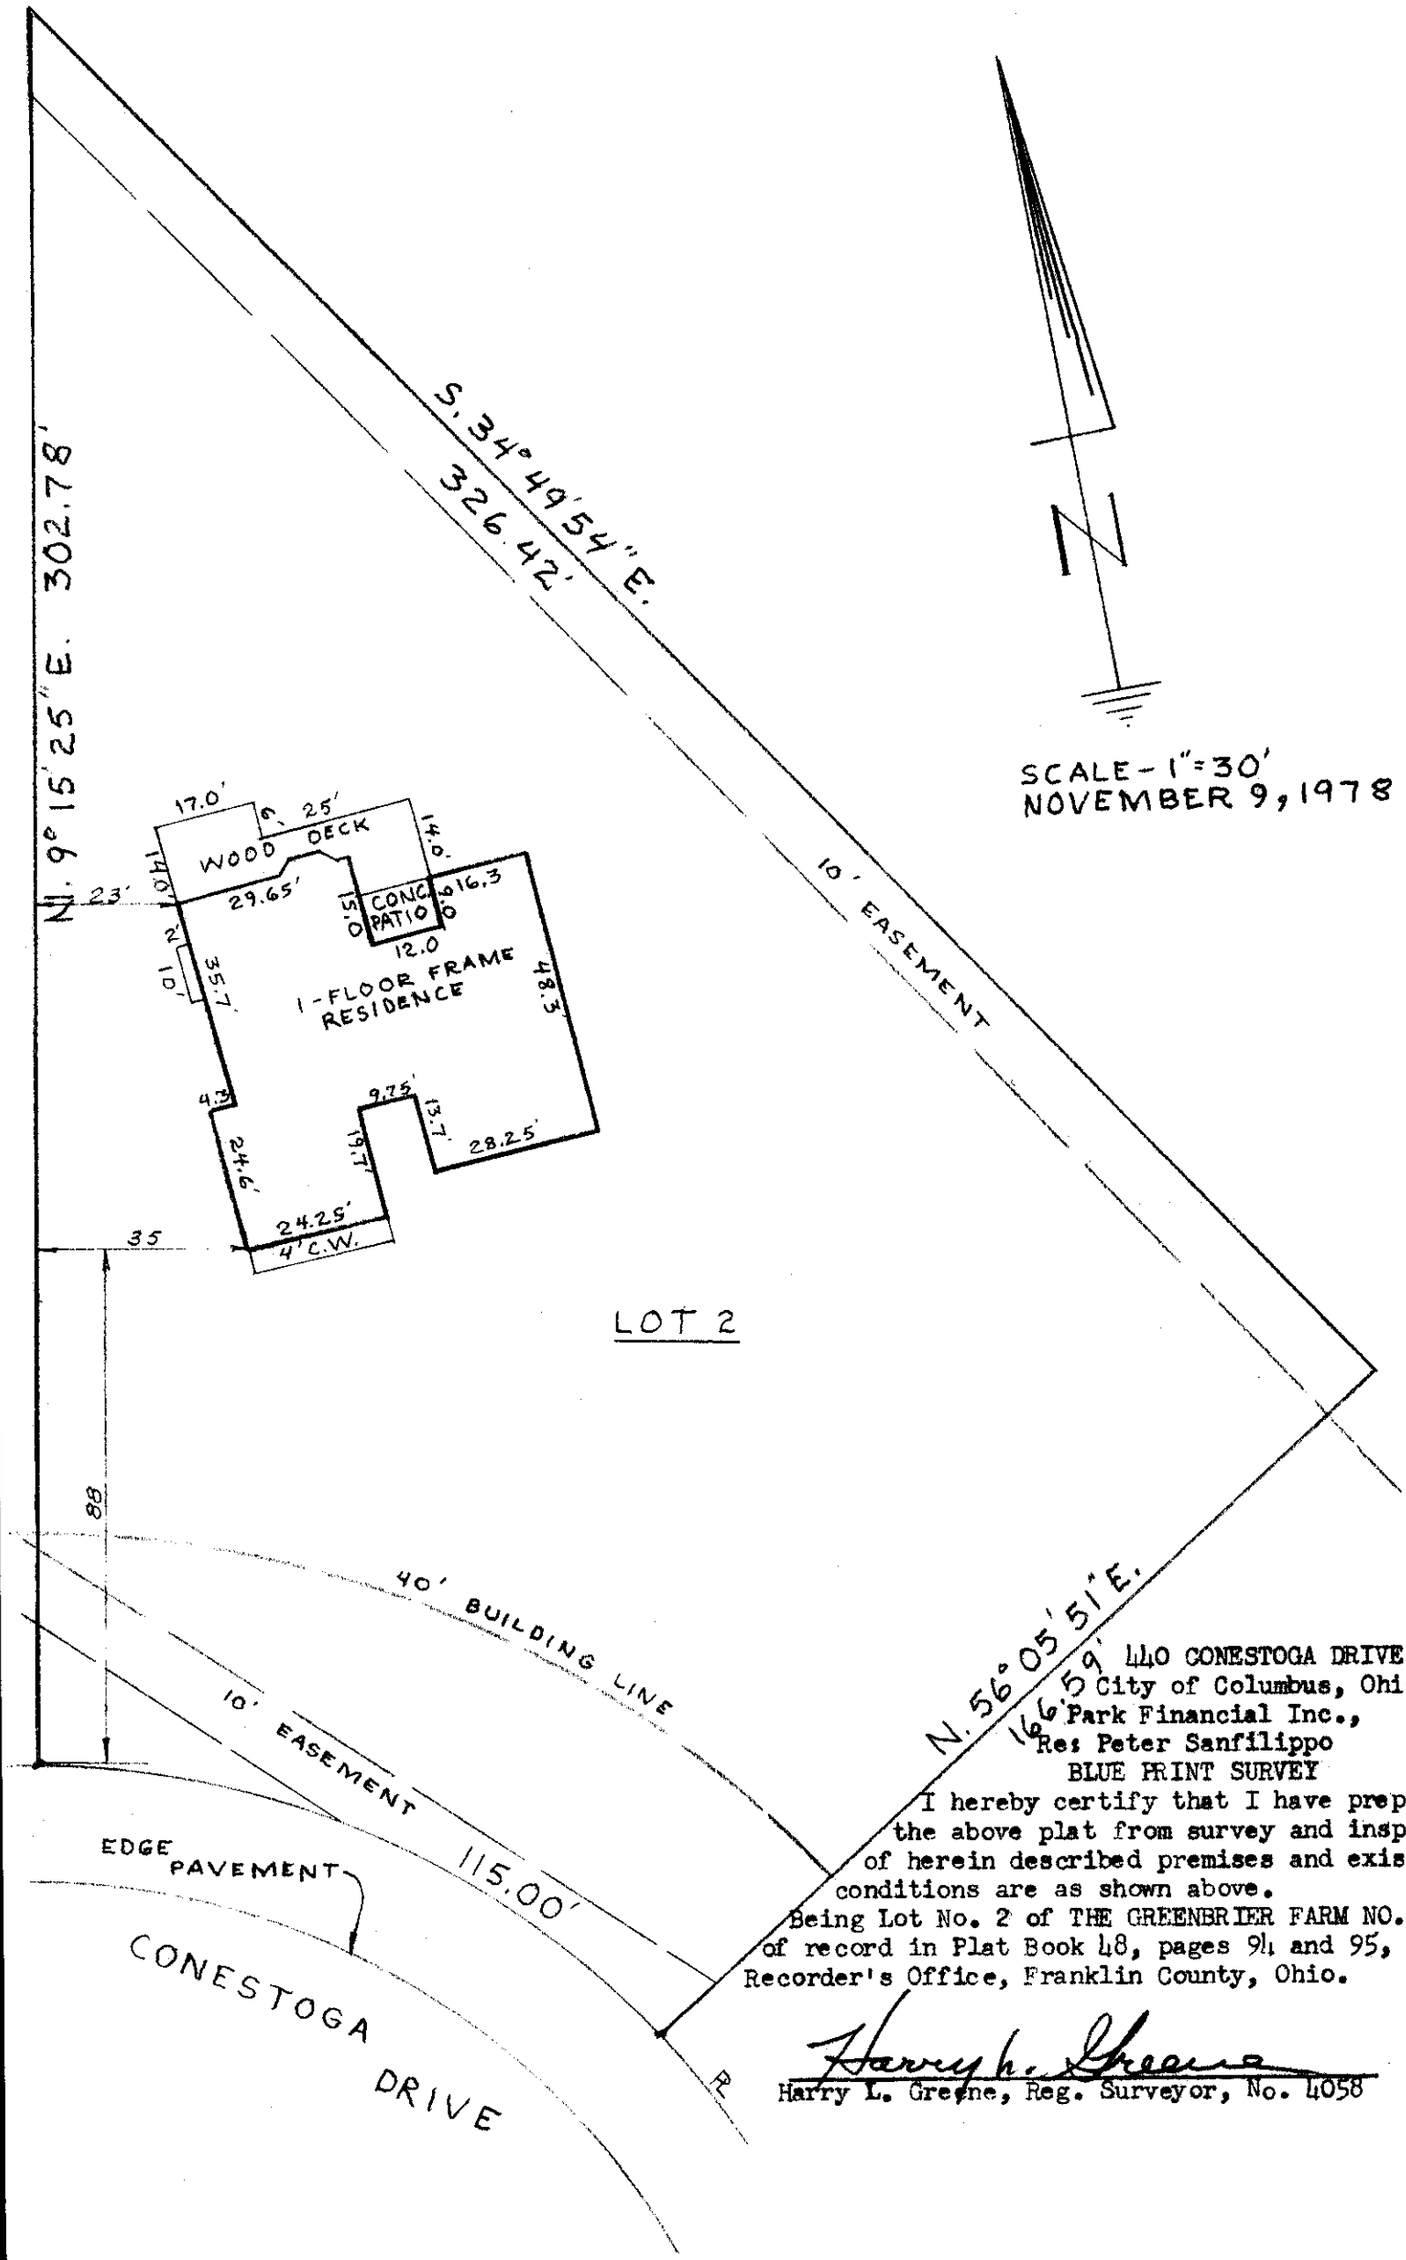

440 CONESTOGA DRIVE.
City of Columbus, Ohio.
Park Financial Inc.,
Re: Peter Sanfilippo
BLUE PRINT SURVEY

I hereby certify that I have prepared the above plat from survey and inspectio of herein described premises and existing conditions are as shown above.

Being Lot No. 2 of THE GREENBRIER FARM NO. 5, of record in Plat Book 48, pages 94 and 95, Recorder's Office, Franklin County, Ohio.

Harry L. Greene

Harry L. Greene, Reg. Surveyor, No. 4058