


ARLINGTON AVE.

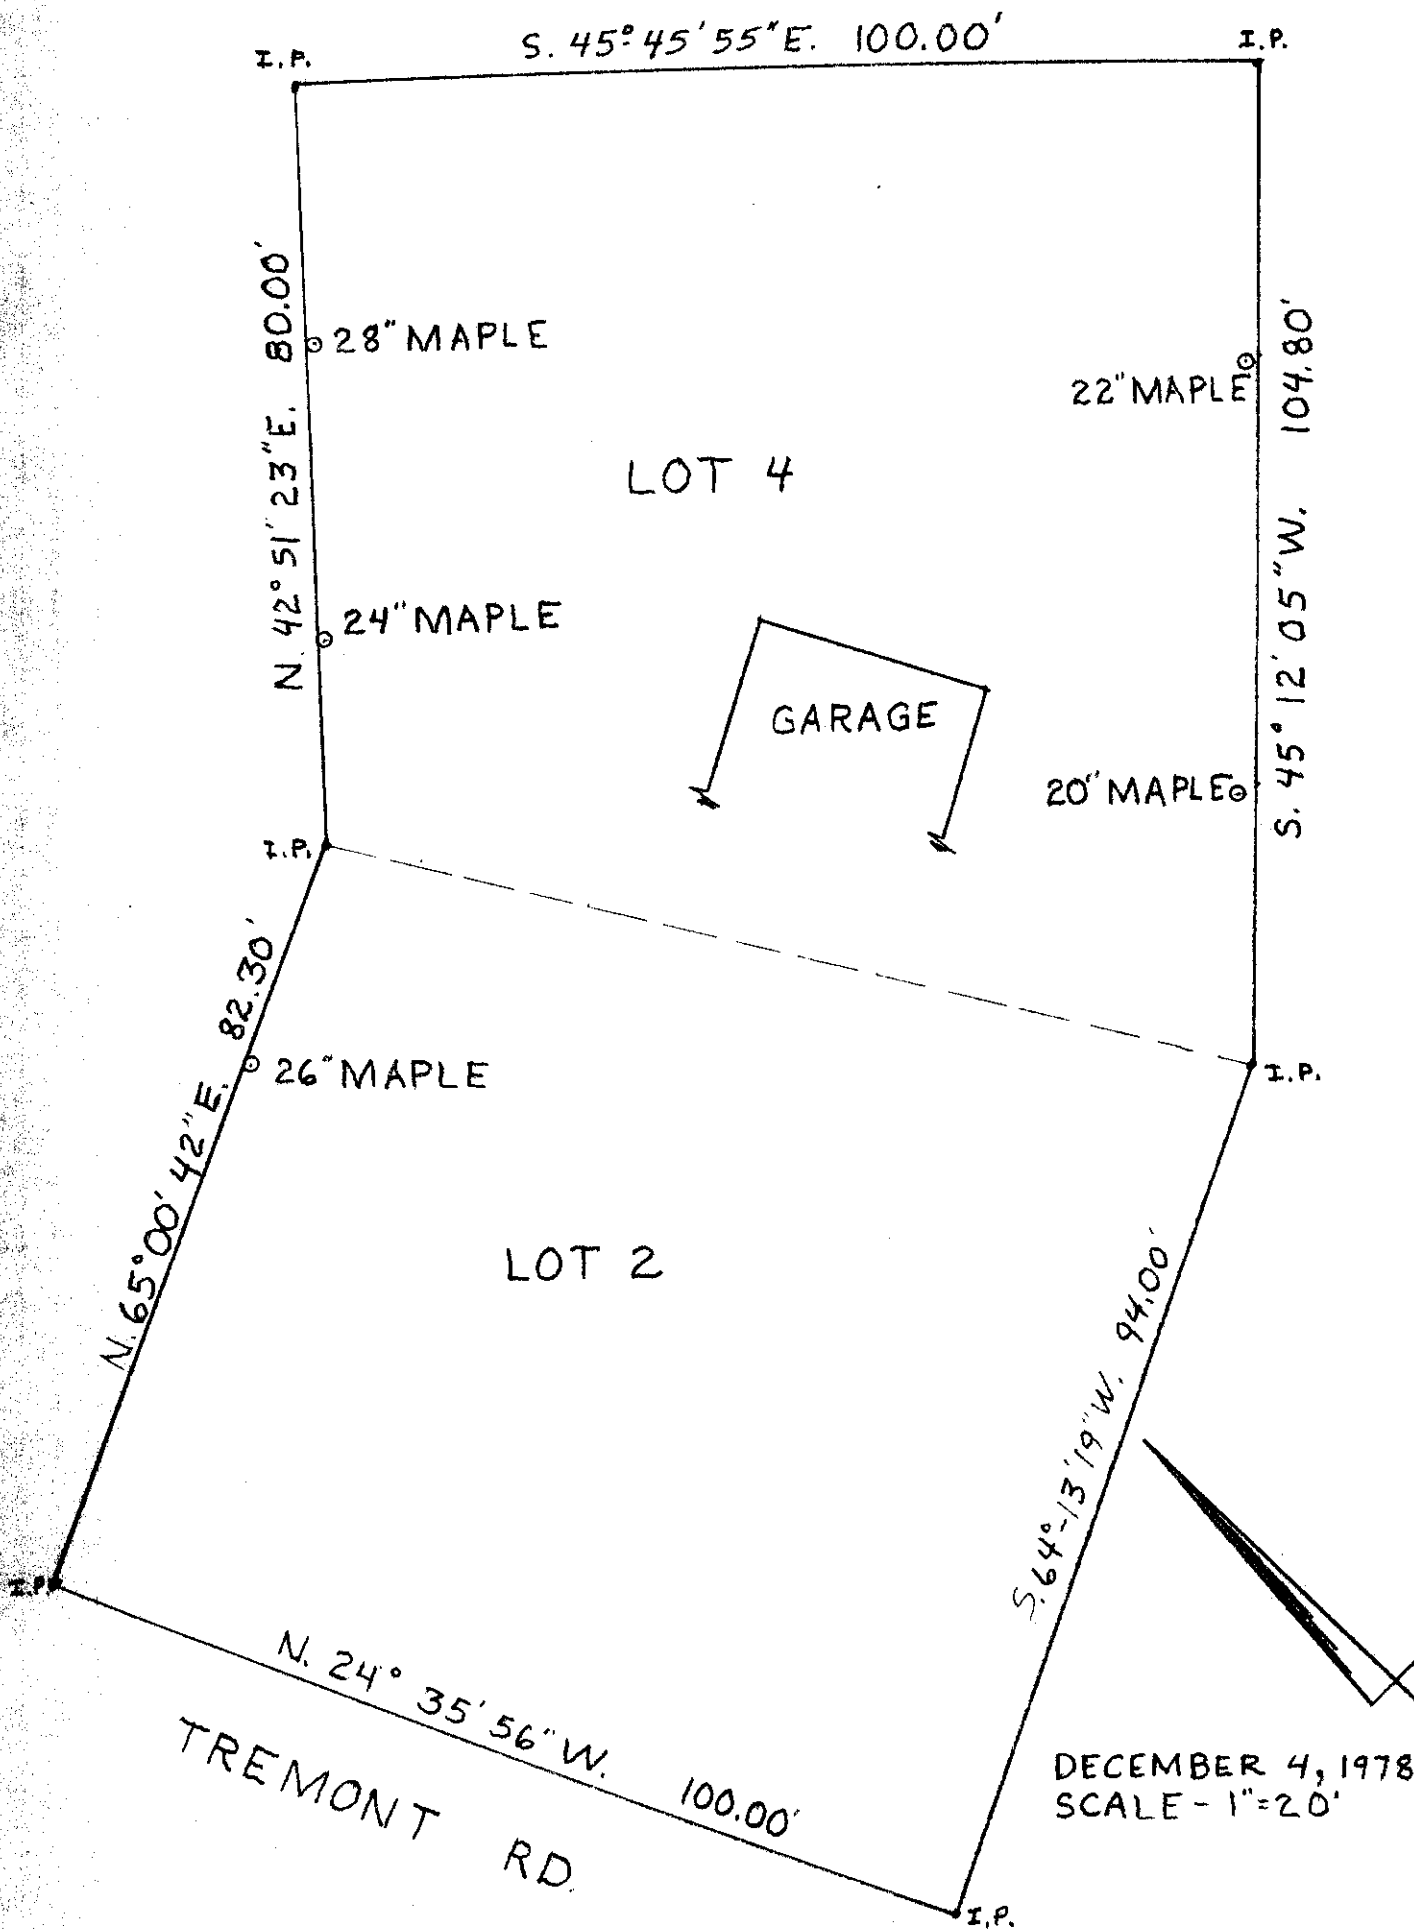

Plat showing survey of Lots Nos. 2 and 4, Block 82, City of Upper Arlington Ohio, for Mr. John Jacob, 2384 Tremont Road, Columbus, Ohio 43221.

Harry L. Greene
Harry L. Greene, Reg. Surveyor, No. 4058