


OLD SPRING LANE

50'R

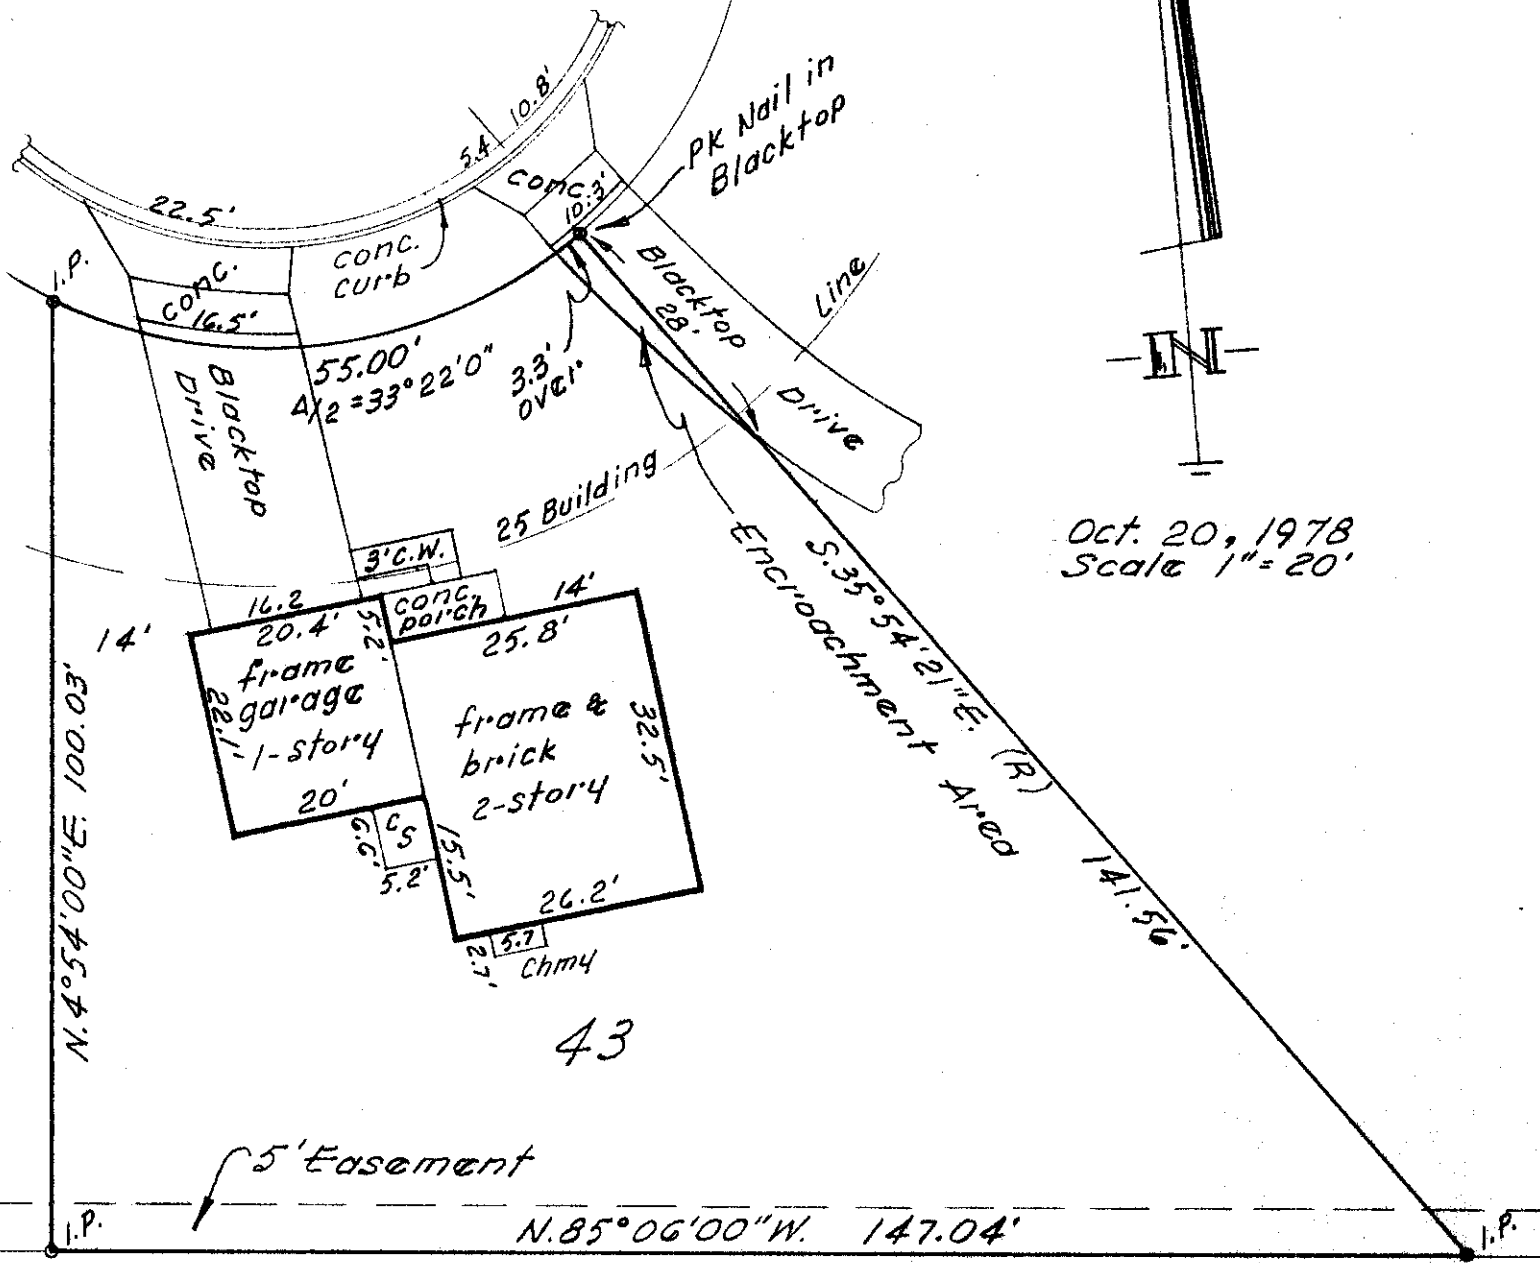

225 OLD SPRING LANE

Village of Dublin, Franklin County, Ohio.

Re: Steven Tokar

~ BLUE PRINT SURVEY ~

I hereby certify that I have prepared the above plat from survey and inspection of herein described premises and existing conditions are as shown above.

Being Lot 43 of WATERFORD VILLAGE PHASE 1, of record in Plat Book 51, Pg. 10 & 11, Recorder's Office, Franklin County, Ohio.

Harry L. Greene

Harry L. Greene, Reg. Surveyor - 4058.