

Harry L. Greene, Surveyor


2160 Tremont Center, Columbus, Ohio 43221

For: Ohio National Bank
Re: Michael & Donna Conrad

Lot No. 26, KENEROOK VALLEY, City of Upper Arlington, Ohio

PB. 46 Page 62 Recorders Office, Franklin County, Ohio.
Scale 1" = 30' Date Nov. 4, 1979

MILLCREEK LANE (60')

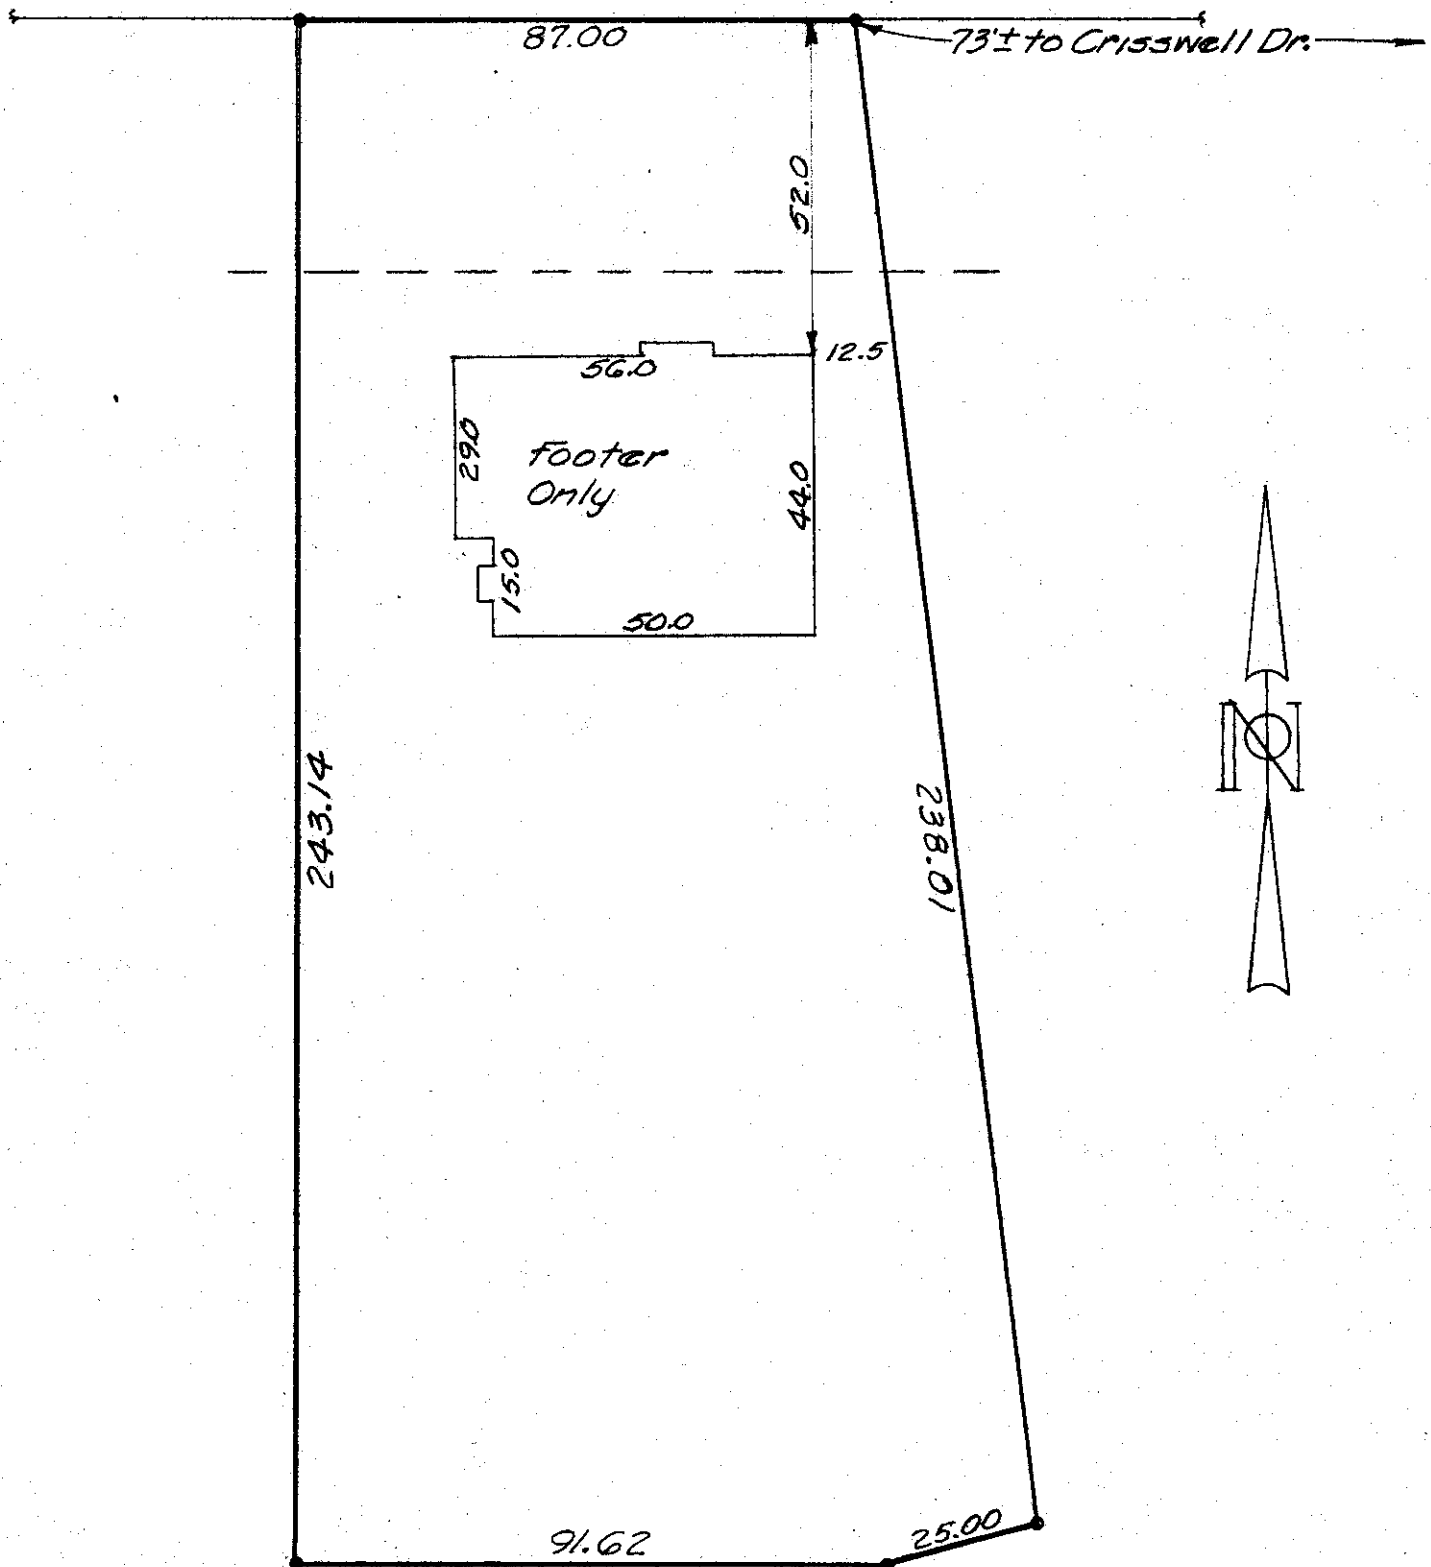

I hereby certify the above plat has been prepared from actual survey of the premises for use in mortgage loan and title purposes only. No sideline of principal building is less than dimension shown. Property corners not located unless shown thus -o-.

Harry L. Greene
Harry L. Greene, Registered Surveyor, No. 4058