


Harry L. Greene, Surveyor

2160 Tremont Center, Columbus, Ohio 43221

For: Lawyer's Title Insurance Corporation,
and/or
BancOhio National Bank
Re: Ermida G. Sorgini

Being Lot No. 105 of WELLINGTON WOODS NORTH SUBDIVISION, City of
Upper Arlington, Ohio.

PB. 12 Page III Recorders Office, Franklin County, Ohio.
Scale 1" = 30' Date September 9, 1980

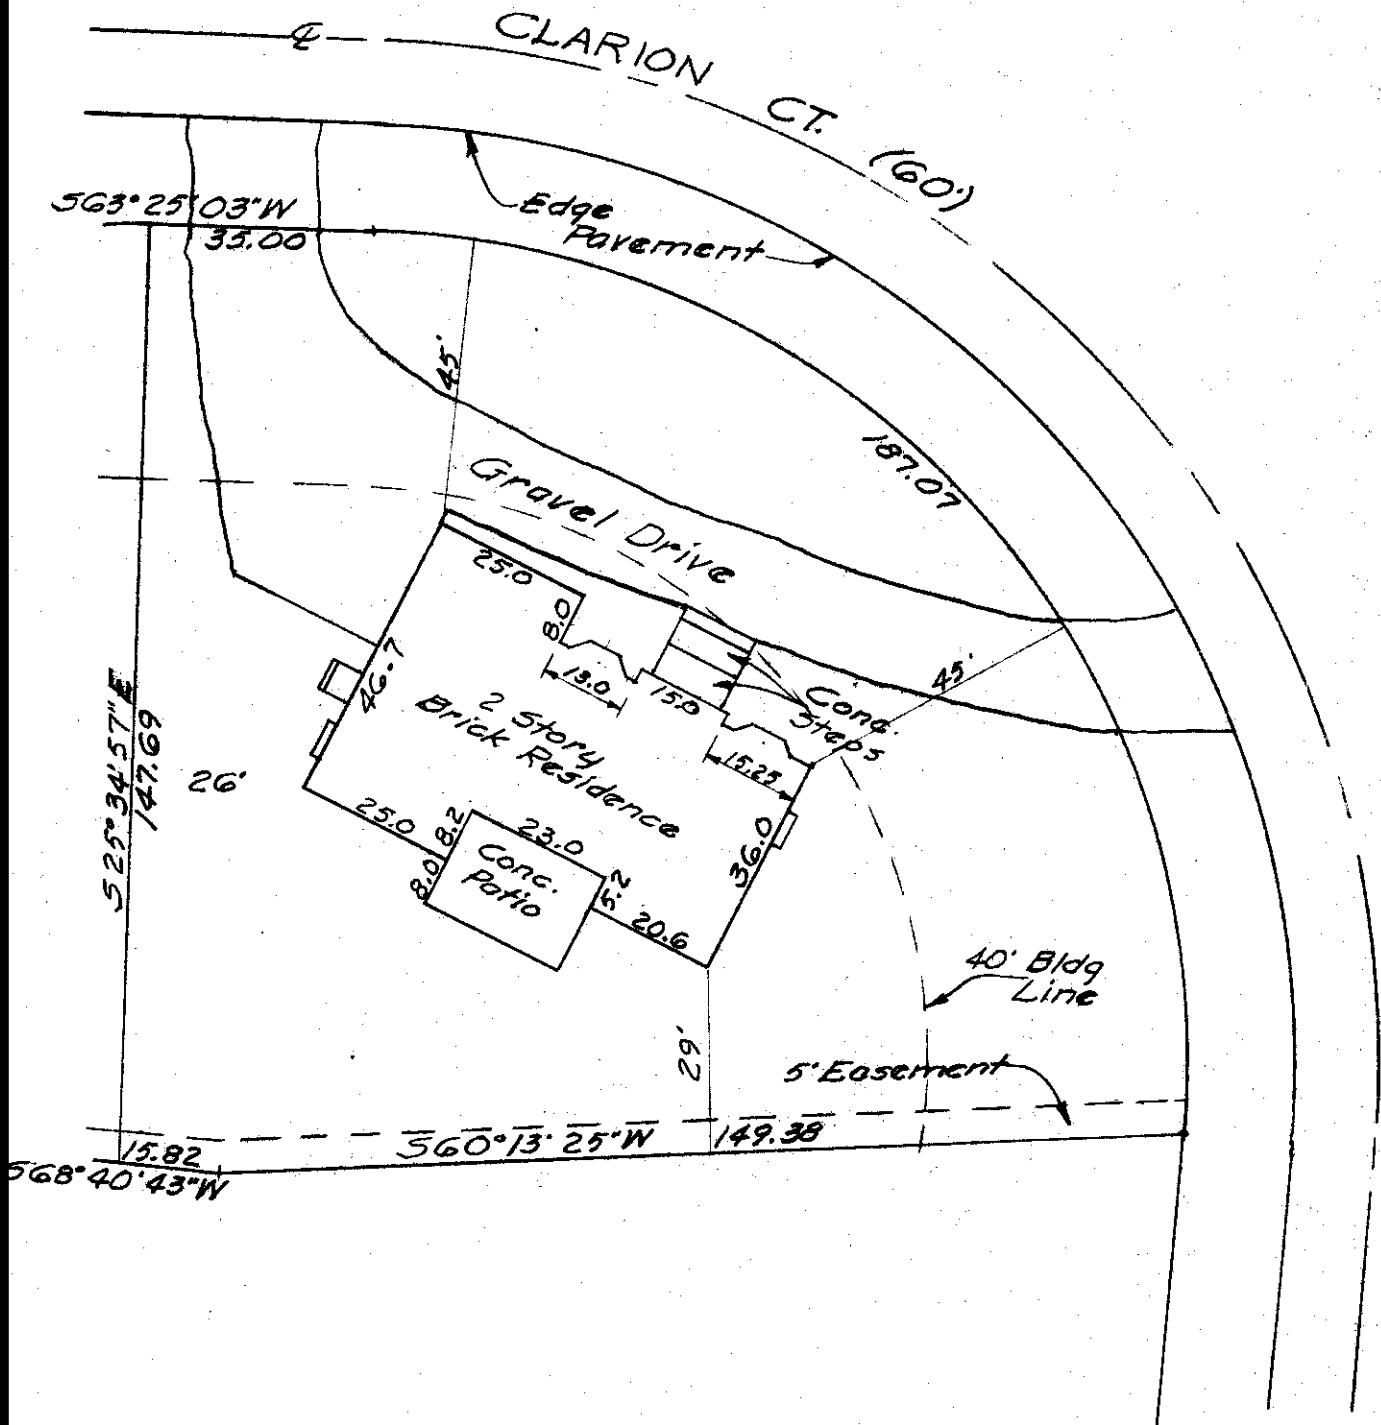

I hereby certify the above plat has been prepared from actual survey of the premises for use in mortgage loan and title purposes only. No sideline of principal building is less than dimension shown. Property corners located unless shown thus -o-.

Harry L. Greene
Harry L. Greene, Registered Surveyor, No. 4098