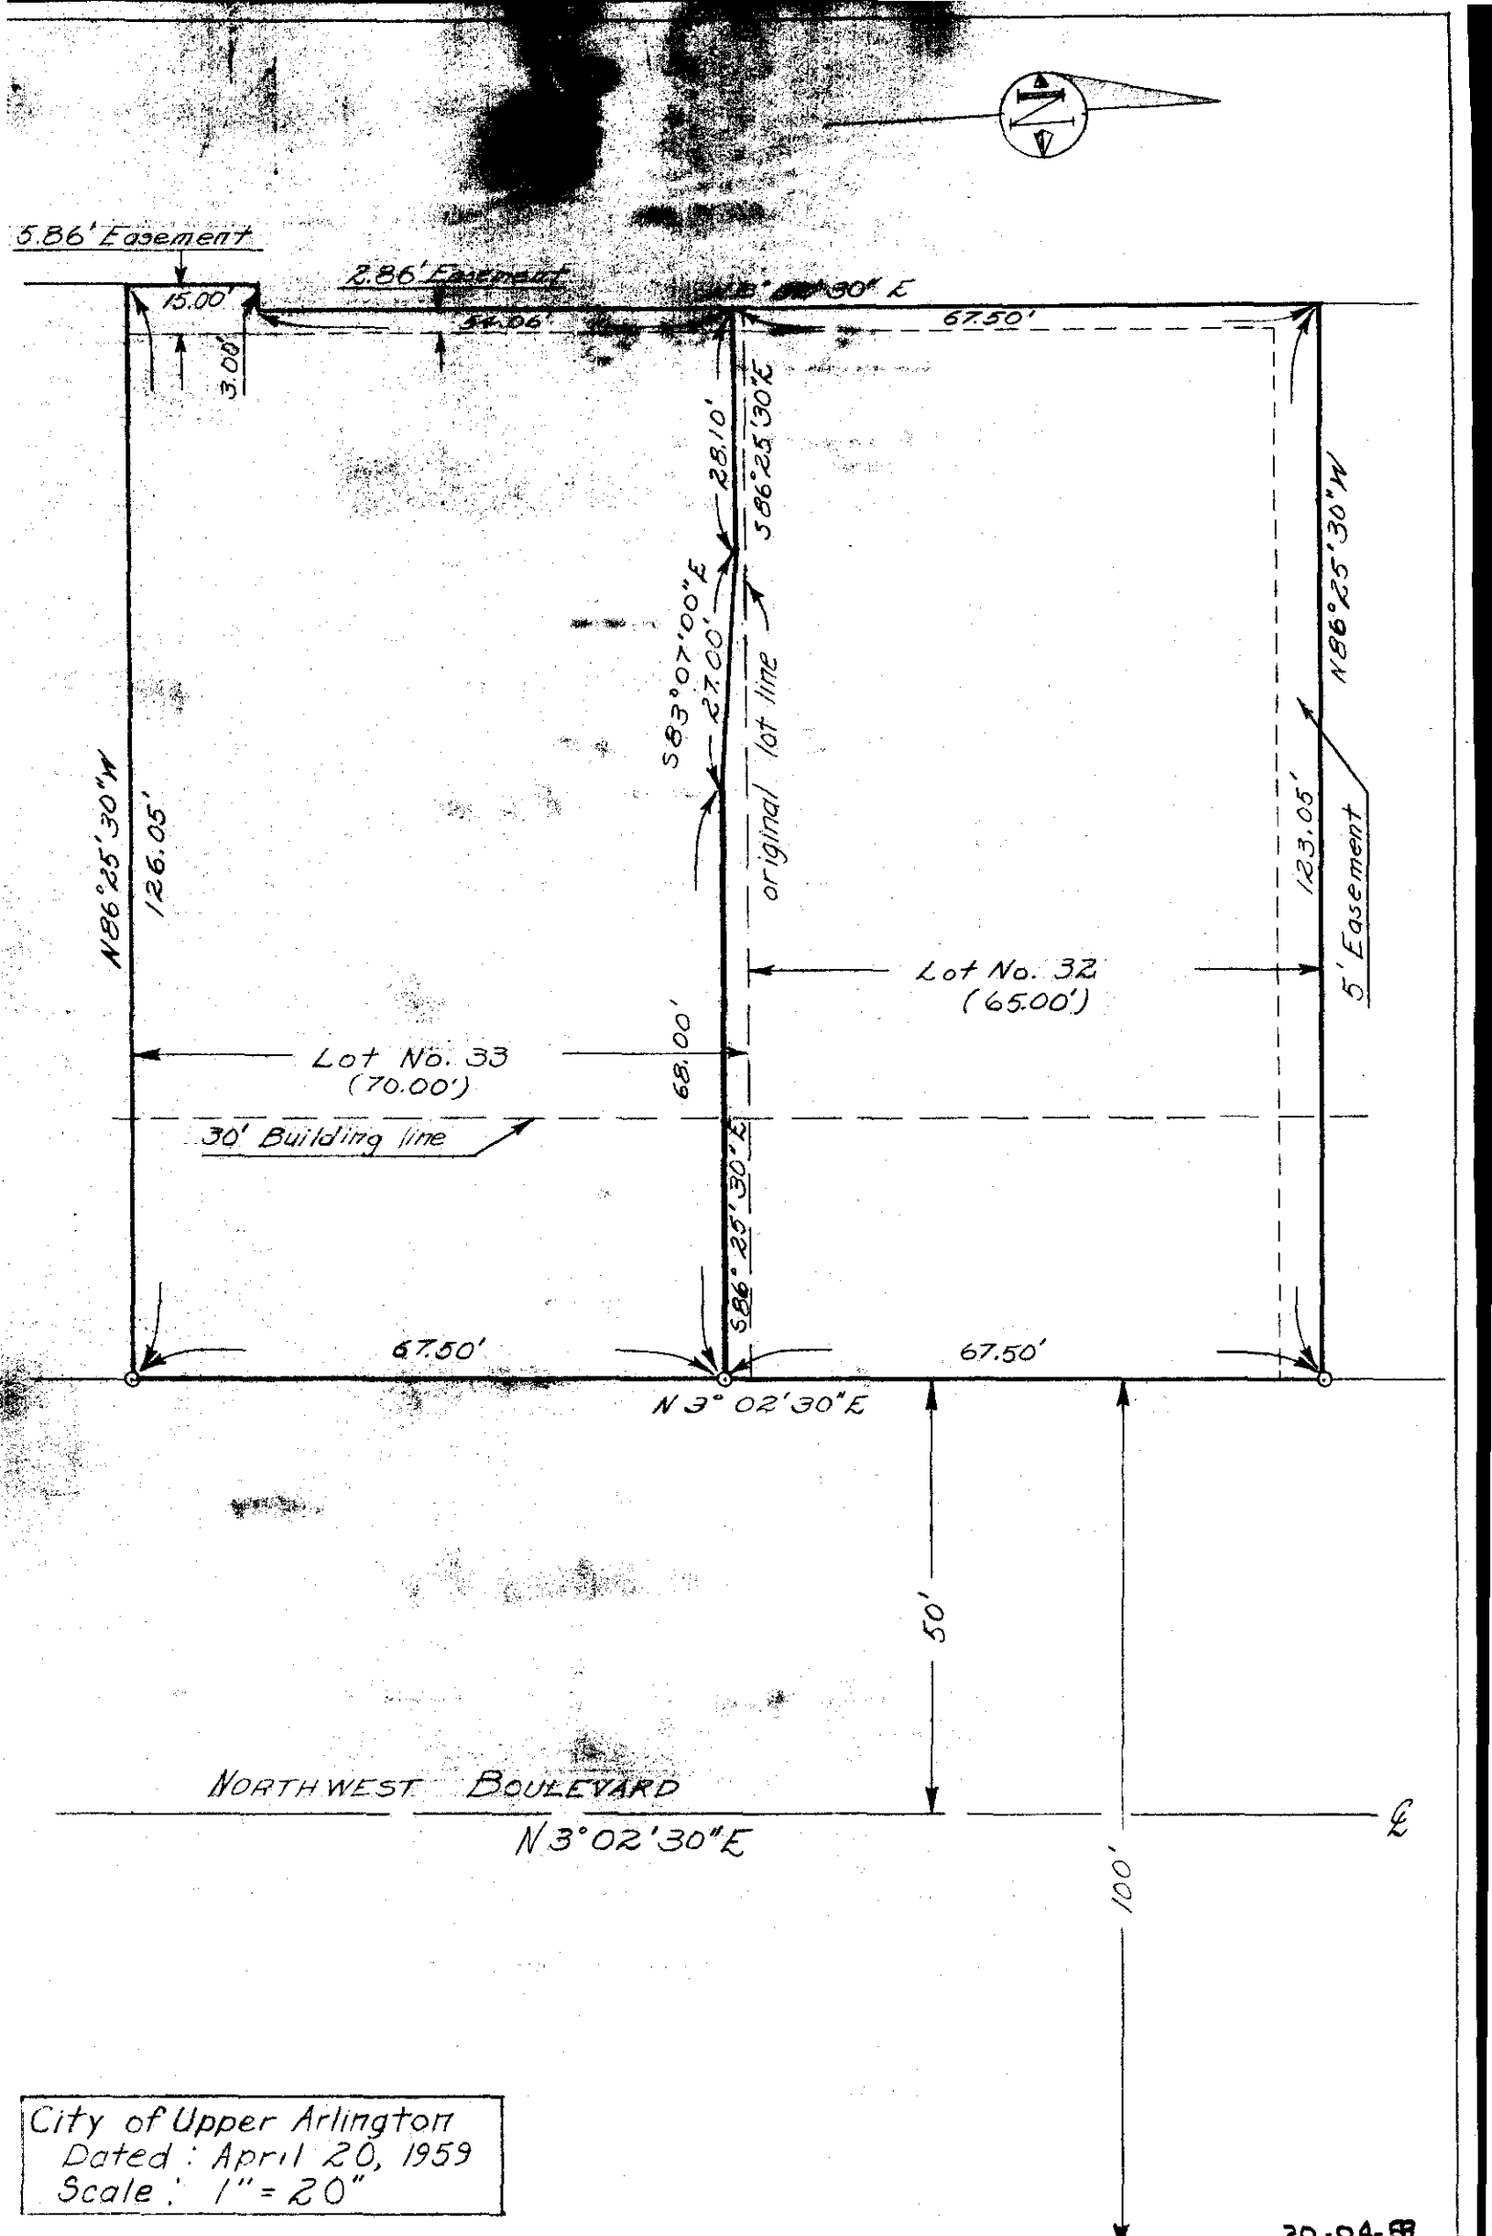

City of Upper Arlington
Dated: April 20, 1959
Scale: 1" = 20"

20-04-59

Sketch showing split of lot numbers 32 and 33 of WELSFORD ADDITION, of record in Plat Book 24, page 23, Recorders Office, Franklin County, Ohio. Harry L. Greene

Harry L. Greene Reg. Surveyor No. 4058