

OKELL

ROAD

50'
Right-of-Way

27'
Improvement

conc. apron

Back of Curb

4' conc. walk

63'

120 ft. to south line
WETMORE ROAD.

31.3'

3' conc. walk

Bldg.

Line

30'

41.4'


Blacktop Drive

1-floor frame,
brick

41.4'

5'

conc. stoop & step

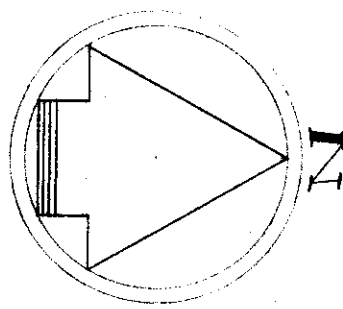

Mar. 30, 1960
Scale 1" = 20'

5' Easements

63.53'

30-03-60

4482 OKELL ROAD

City of Columbus, Franklin County, Ohio.
Galbreath Mortgage Company.
Re: Verner W. Colflesh.

Blue Print Survey

I hereby certify that I have prepared the above plat from survey and inspection of herein described premises and existing conditions are as shown above.

Being Lot No. 209 of MAIZE MEADOWS, a subdivision, of record in Plat Book 29, pages 46 & 47, Recorder's Office, Franklin County, Ohio.

Harry L. Greene
Harry L. Greene, Reg. Surveyor - No. 1058