


BEAUTYVIEW COURT

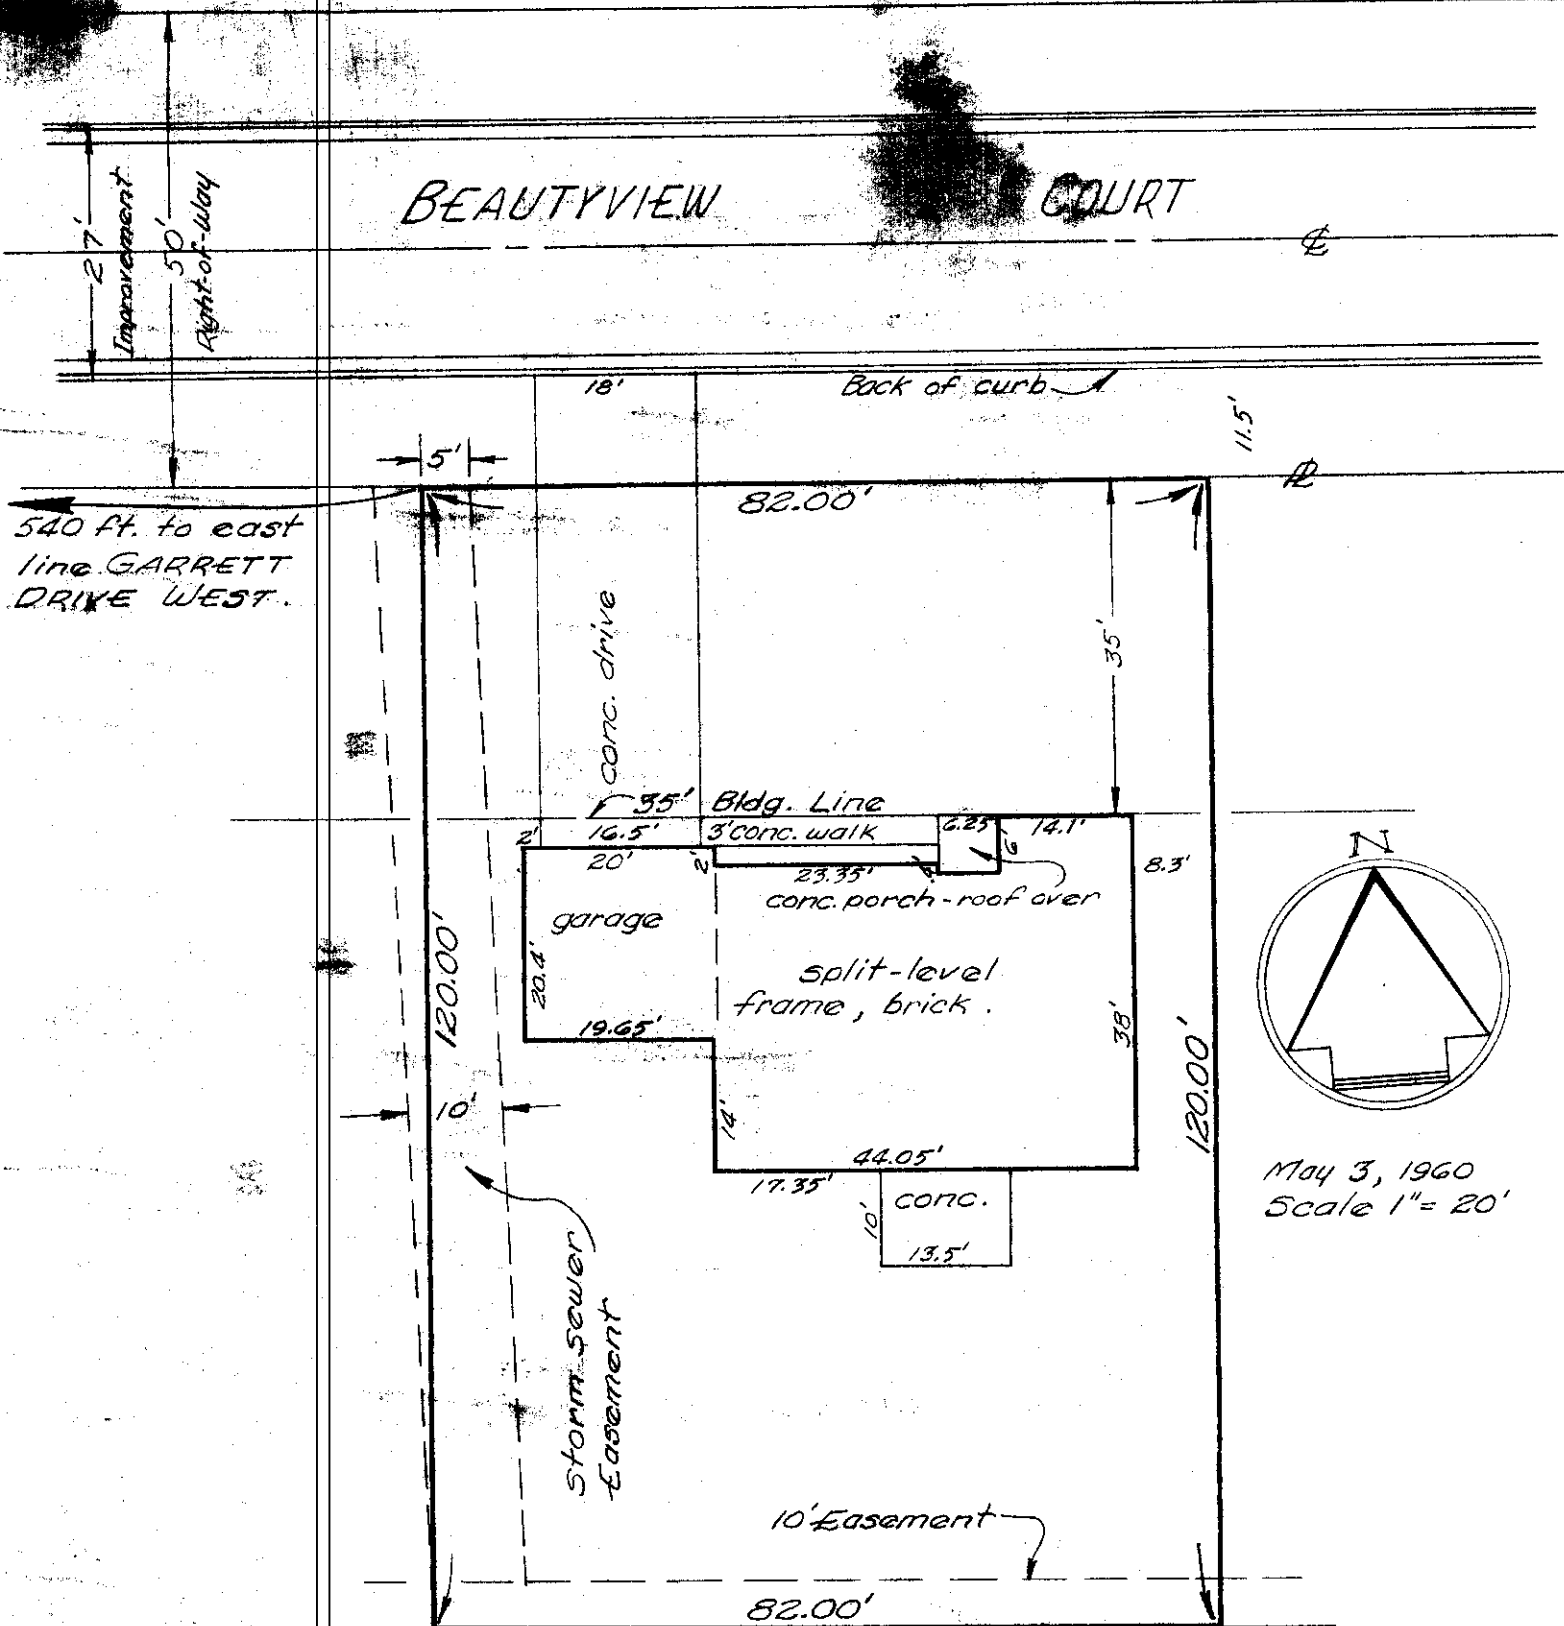

03-05-60

701 BEAUTYVIEW COURT  
City of Columbus, Franklin County, Ohio.  
Galbreath Mortgage Company.  
Re: Jack O. Evans.

Blue Print Survey

I hereby certify that I have prepared the above plat from survey and inspection of herein described premises and existing conditions are as shown above.

Being LOT No. 113 of BEAUTY VIEW ADDITION, of record in Plat Book 28, page 17, Recorder's Office, Franklin County, Ohio.

Harry L. Greene

Harry L. Greene, Reg. Surveyor - No. 4058.