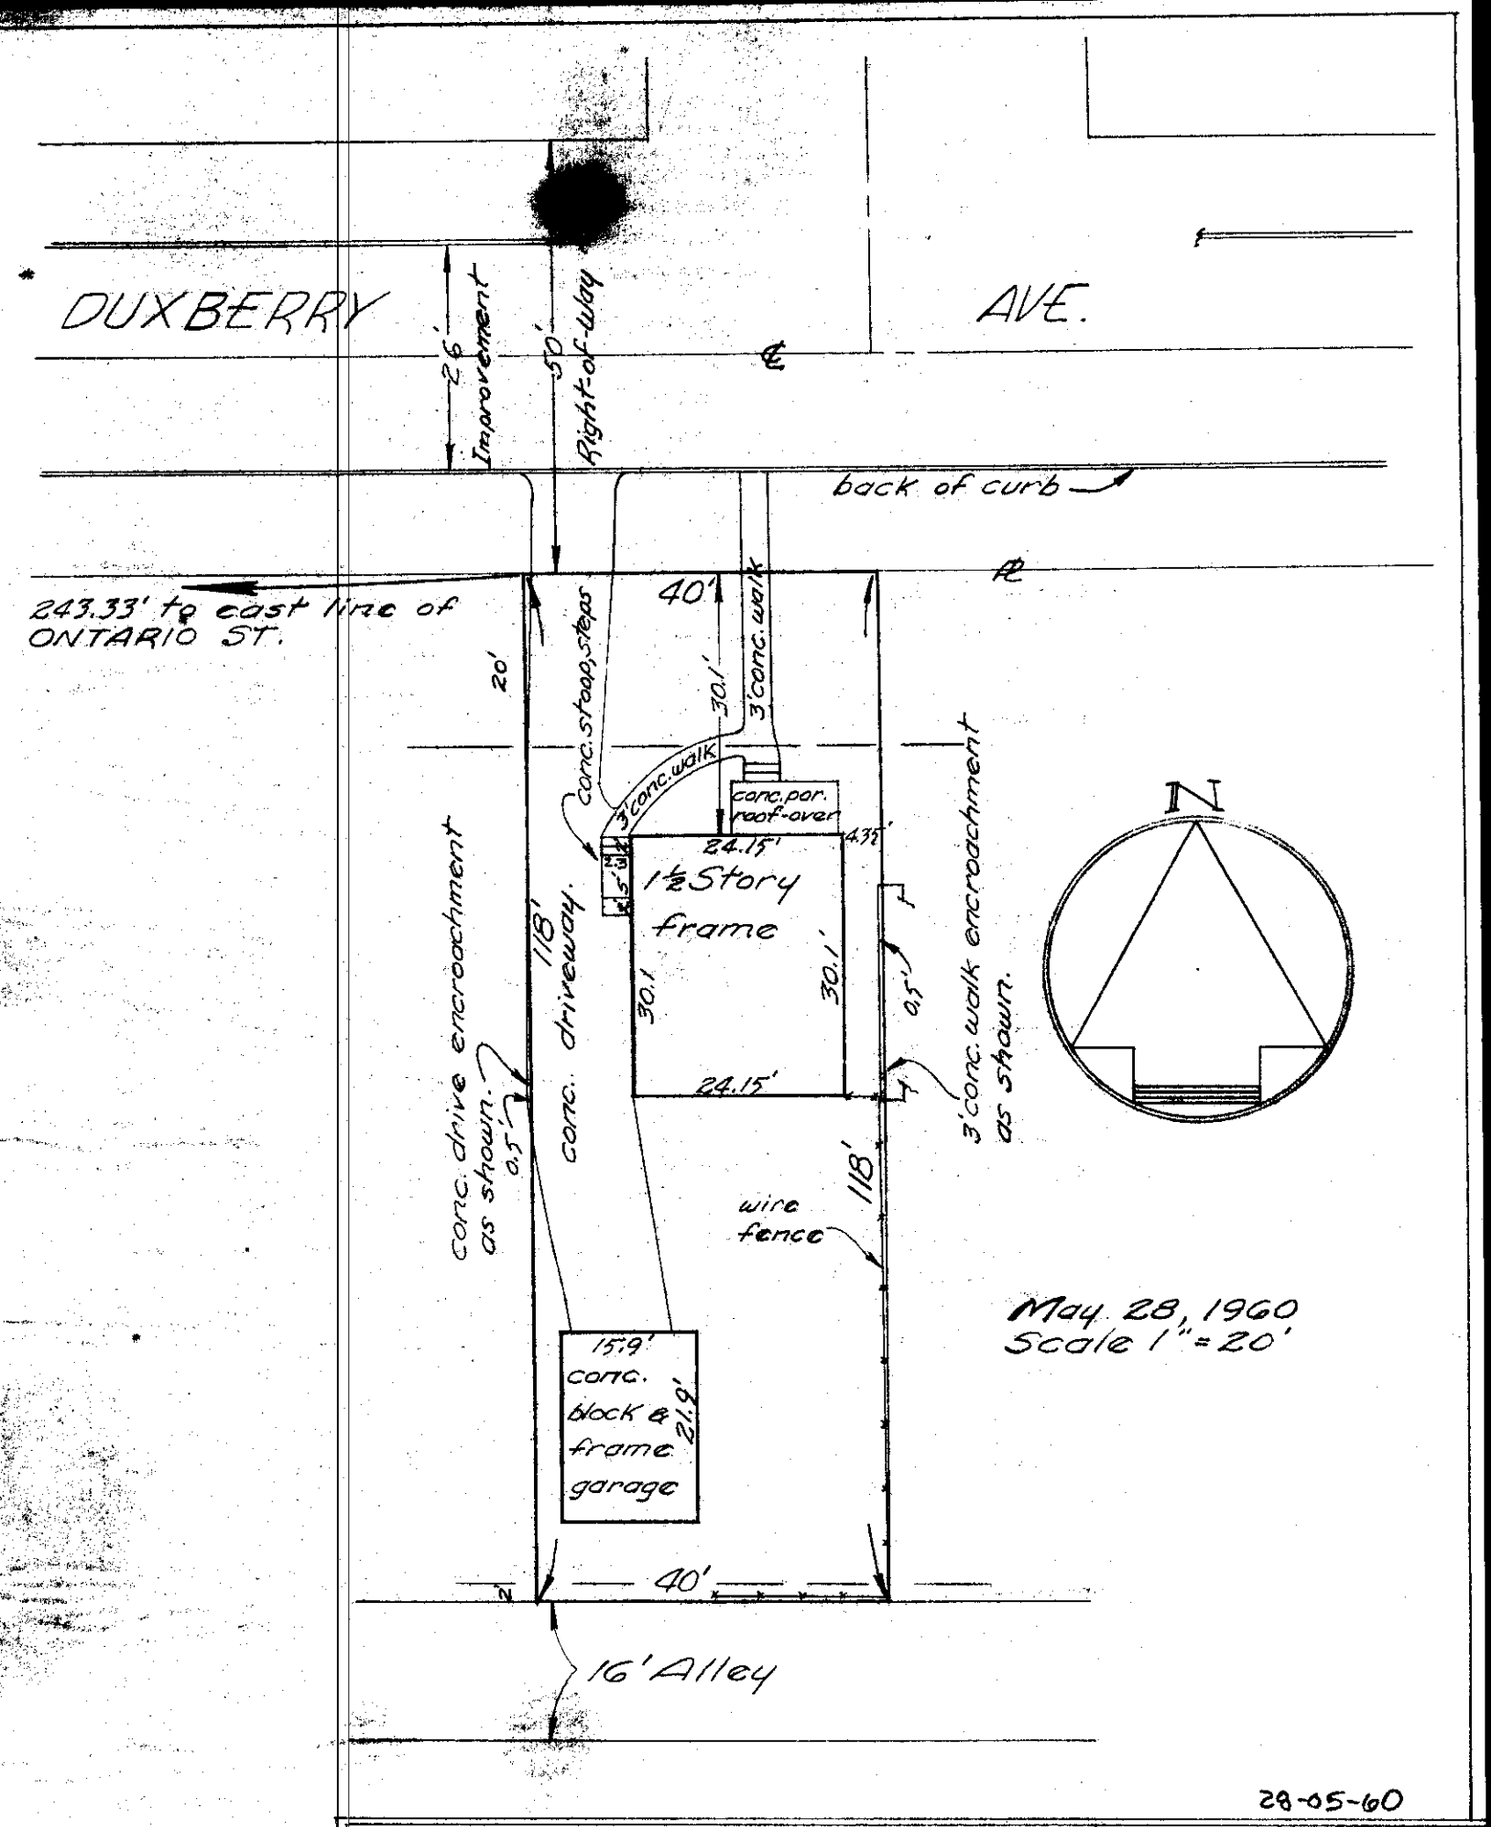

1235 DUXBERRY AVE.
City of Columbus, Franklin County, Ohio.
Galbreath Mortgage Company.
Re: Jack A. Taynor.

~ Blue Print Survey ~

I hereby certify that I have prepared the above plat from survey and inspection of herein described premises and existing conditions are as shown above.
Being Lot No. 95 of HOMESTEAD HEIGHTS No. 2, of record in Plat Book 16, pg. 40, Recorder's Office, Franklin County, Ohio.

Harry L. Greene

Harry L. Greene, Reg. Surveyor - No. 4058.