


June 8, 1960
Scale 1" = 20'

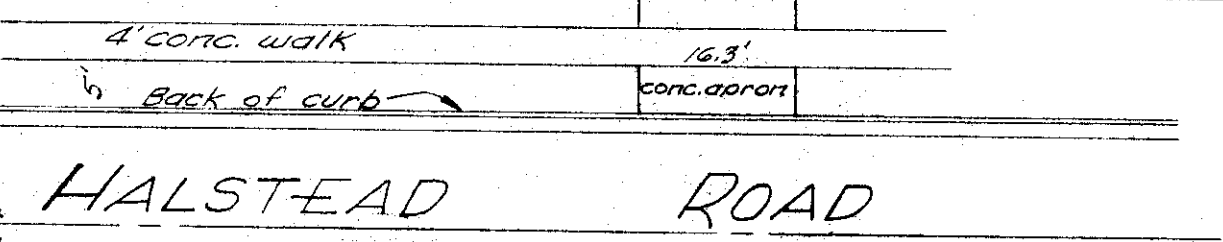

5.6' Easement

50' Right-of-way

08-06-60B

2927 HALSTEAD ROAD
City of Upper Arlington, Franklin County, Ohio.
Galbreath Mortgage Company.
Re: William E. Shultz.

Blue Print Survey

I hereby certify that I have prepared the above plat from survey and inspection of herein described premises and existing conditions are as shown above.

Being Lot No. 45 of the WALLACE F. ACKLEY SUBDIVISION, of record in Plat Book 25, pg. 19, Recorder's Office, Franklin County, Ohio.

Harry L. Greene
Harry L. Greene, Reg. Surveyor - No. 4058.