


STONEHENGE COURT

No Improvement in place at date of survey

60' Right-of-Way

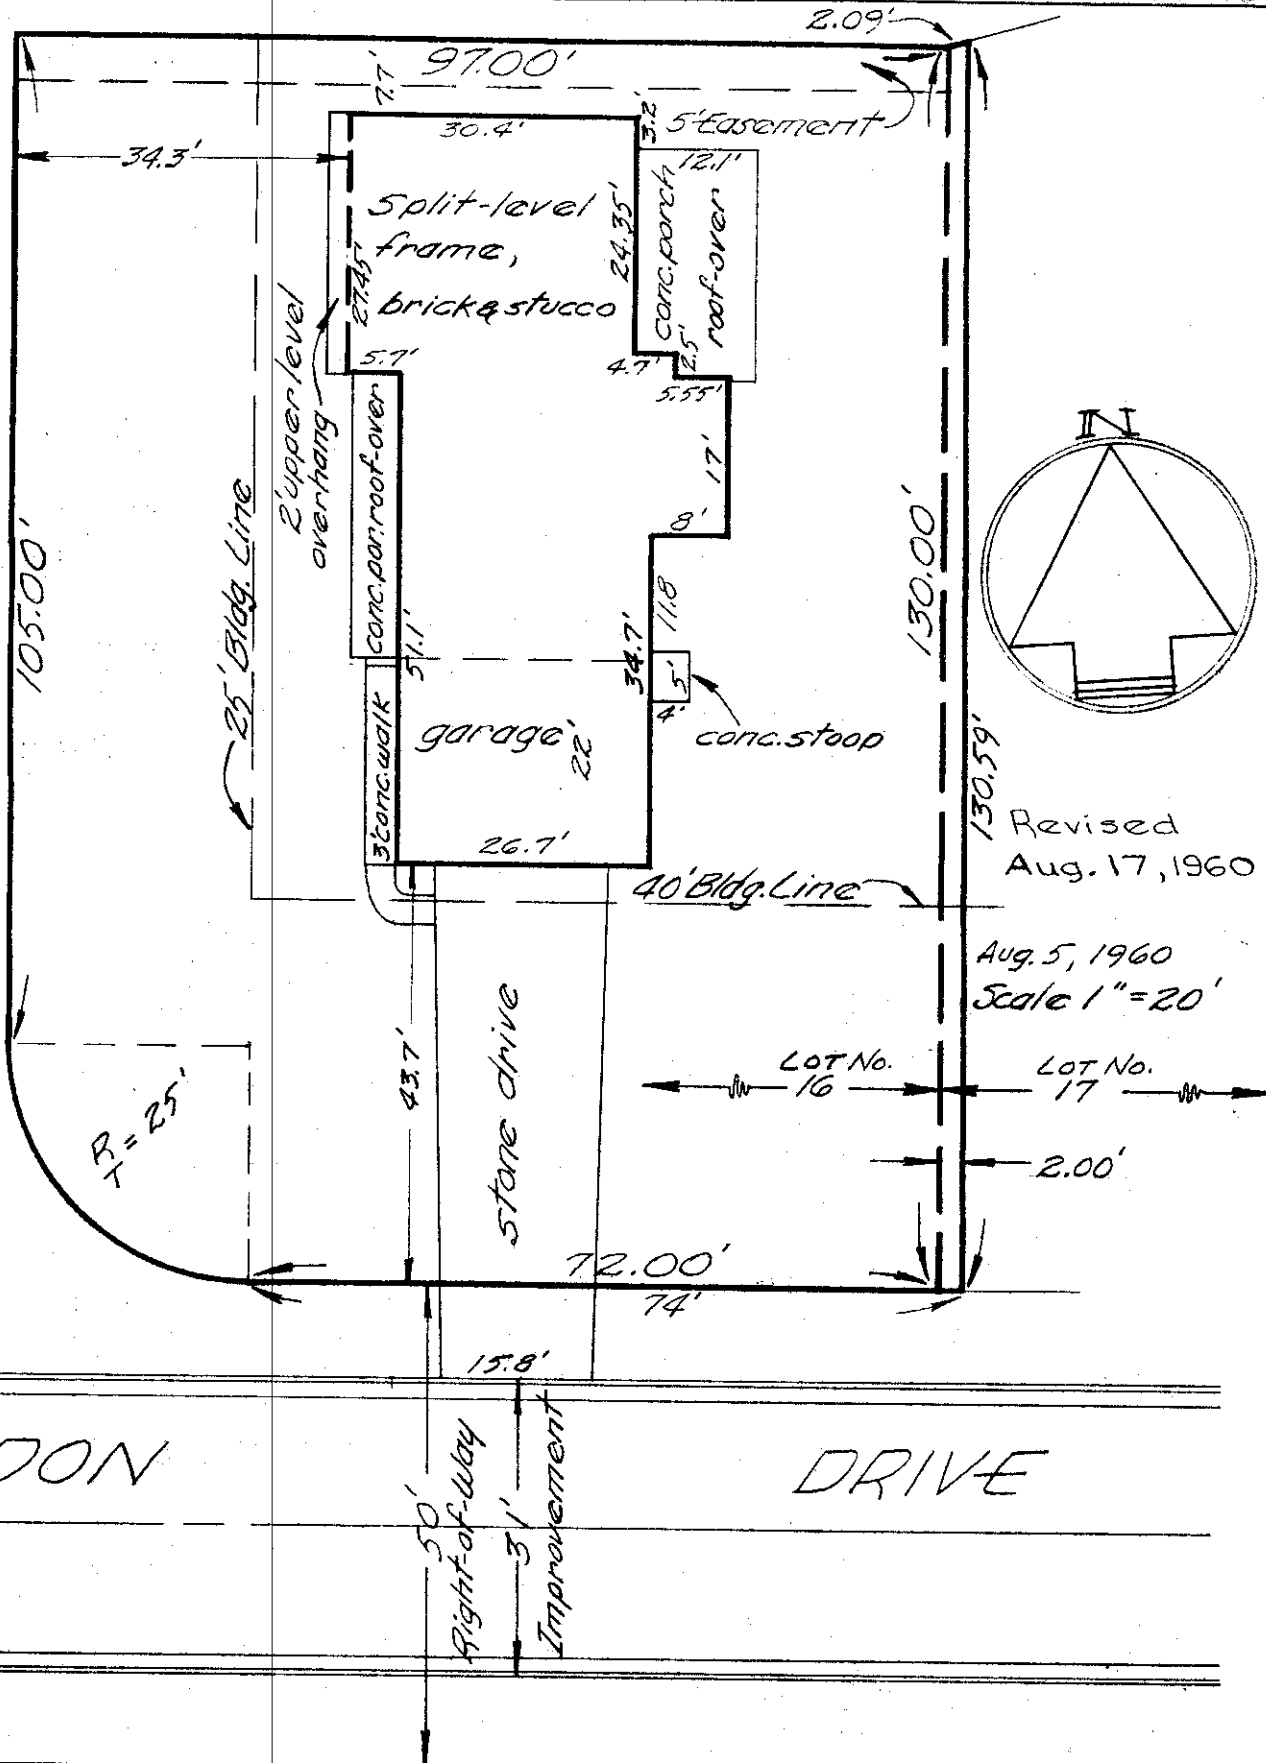

LONDON

DRIVE

05-08-60C

3361 STONEHENGE COURT
 City of Upper Arlington, Franklin County, Ohio.
 Galbreath Mortgage Company.
 Re: Martin G. & Bernadine M. Winter.
 Blue Print Survey
 I hereby certify that I have prepared the above plat from survey and inspection of herein described premises and existing conditions are as shown above.
 Being LOT No. 16 of WESTWOOD Acres EXTENSION No. 1, of record in Plat Book 33, pg. 23, Recorder's Office, Franklin County, Ohio; and including 2.00 ft. off the entire West Side of Lot No. 17, of said subdivision.
 Harry L. Greene
 Harry L. Greene, Reg. Surveyor No. 4058.