


BRAIDWOOD DRIVE

20' Improvement
50' Rt-of-way
No Curbs

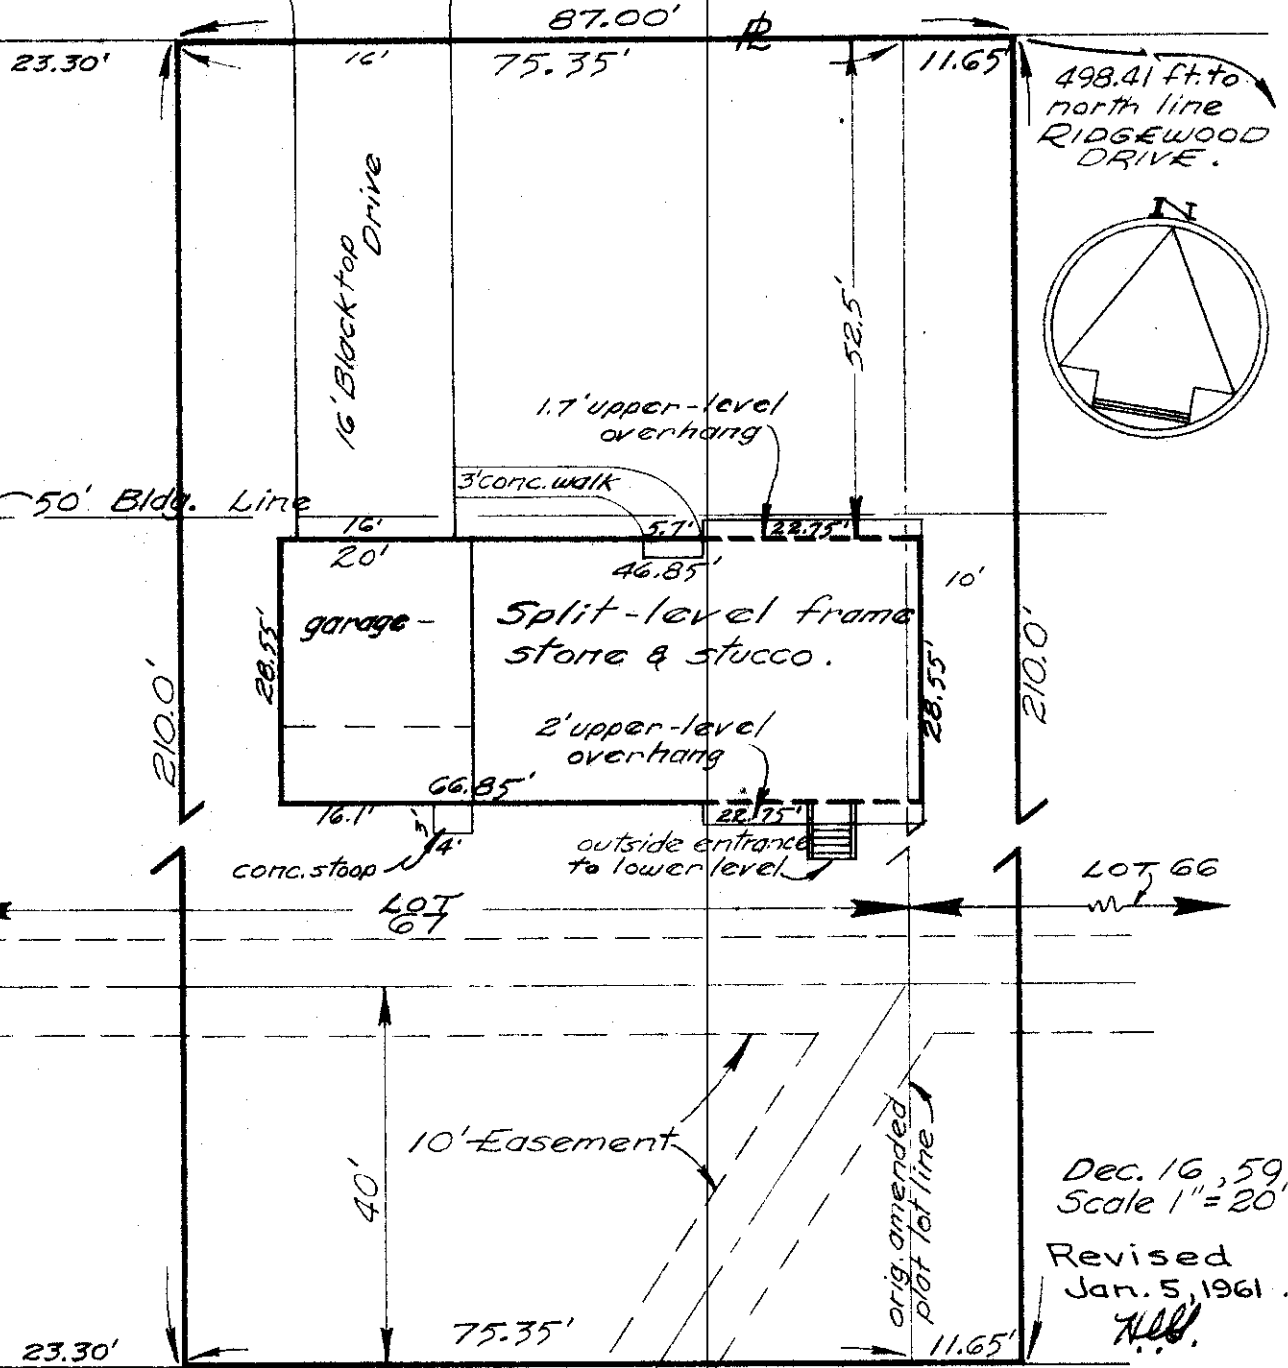

Case No. 41160

3301 BRAIDWOOD DRIVE
Franklin County, Ohio. Norwich Township
Lawyers Title Insurance Corp. & Pacific Mutual Life Insurance Company.
Re: Donald Scoles.
~ Blue Print Survey ~
I hereby certify that I have prepared the above plat from survey and inspection of herein described premises and existing conditions are as shown above.
Being 11.65 ft. of the west side of Lot No. 66 and 75.35 ft. of the east side of Lot No. 67 (total 87.0 ft.), of the AMENDED PLAT OF PART OF RIDGEWOOD ESTATES, of record in Plat Book 25, page 36, Recorder's Office, Franklin County, Ohio.

Harry L. Greene

Harry L. Greene, Reg. Surveyor No. 4058.